


STATE OF KANSAS
STATE CORPORATION COMMISSION

WELL PLUGGING RECORD

Give All Information Completely
Make Required Affidavit
Mail or Deliver Report to:
Conservation Division
State Corporation Commission
212 North Market, Insurance Bldg.
Wichita, Kansas

Ellis County, Sec. 9 Twp. 11S Rge. 18W (X) (W)

Location as "NE/CNW/SW" or footage from lines SE-NE-SE
Lease Owner Petroleum, Inc.
Lease Name Moistrell "D" Well No. 1
Office Address Route #2, Great Bend, Kansas
Character of Well (completed as Oil, Gas or Dry Hole) Dry Hole
Date well completed May 11 1959
Application for plugging filed May 11 1959
Application for plugging approved May 11 1959
Plugging commenced May 11 1959
Plugging completed May 11 1959
Reason for abandonment of well or producing formation No producible zone

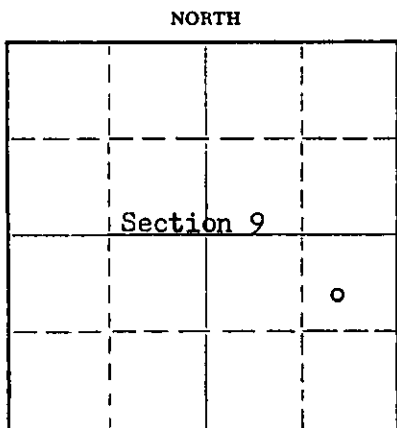

Locate well correctly on above Section Plat

If a producing well is abandoned, date of last production None 19
Was permission obtained from the Conservation Division or its agents before plugging was commenced? yes

Name of Conservation Agent who supervised plugging of this well Eldon Petty, Hays, Kansas
Producing formation --- Depth to top --- Bottom --- Total Depth of Well 3484 Feet
Show depth and thickness of all water, oil and gas formations.

OIL, GAS OR WATER RECORDS

CASING RECORD

FORMATION	CONTENT	FROM	TO	SIZE	PUT IN	PULLED OUT
				8-5/8"	254'	None

Describe in detail the manner in which the well was plugged, indicating where the mud fluid was placed and the method or methods used in introducing it into the hole. If cement or other plugs were used, state the character of same and depth placed, from --- feet to --- feet for each plug set.

Filled hole to base of well celler with heavy mud, Placed plug on top of mud, squeezed with 125 sacks of cement. Plug pumped to 380' while displacing cement. Cemented to base of well celler.

RECEIVED
STATE CORPORATION COMMISSION

MAY 28 1959

CONSERVATION DIVISION
Wichita, Kansas

(If additional description is necessary, use BACK of this sheet)

Name of Plugging Contractor Garvey Drilling Company
Address Route #2, Great Bend, Kansas

STATE OF Kansas, COUNTY OF Barton, ss.
Don Searle (employee of owner) or (owner/operator) of the above-described well, being first duly sworn on oath, says: That I have knowledge of the facts, statements, and matters herein contained and the log of the above-described well as filed and that the same are true and correct. So help me God.

(Signature) Don Searle
Route #2, Great Bend, Kansas (Address)

SUBSCRIBED AND SWORN TO before me this 27th day of May, 1959

Arthur J. Miles Notary Public.

My commission expires April 14, 1963

PLUGGING
FILE SEC. 9 T. 11 R. 18W
BOOK PAGE 38 LINE 5

WELL LOG

COMPANY PETROLEUM, INCORPORATED

SEC. 9 T. 11S R. 18W

FARM MEISTRELL "D" NO. 1

LOC. SE, NE, SE


TOTAL DEPTH 3484'

COUNTY ELLIS CO., KANSAS

COMM. April 29, 1959

COMP. May 11, 1959

CONTRACTOR GARVEY DRILLING COMPANY

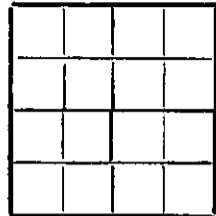

CASING 8 5/8" @ 254' W/150 sax.

ELEVATION 1878' DF

PRODUCTION D & A

FIGURES INDICATE BOTTOM OF FORMATIONS

12	Sand
45	Blue shale
254	Shale & shells
690	Shale
880	Sand
1075	Shale & shells
1185	Red bed
1218	Anhydrite
1330	Shale
1515	Red bed & shale
1735	Shale
1960	Shale & shells
2620	Shale & lime
2835	Shale
3067	Lime
3092	Lime & shale
3147	Lime
3172	Lime & shale
3415	Lime
3450	Lime & chert
3458	Lime, shale & chert
3484	Lime
3484	T. D.

RECORDED
STATE CORPORATION COMMISSION

MAY 28 1959

CONSERVATION DIVISION
Wichita, Kansas

PLUGGING
FILE SEC. 9 T. 11 S. R. 18 W.
BOOK PAGE 38 LINE 3

State of KANSAS }
County of BARTON } SS:

I, VERNE A. MORRIS of GARVEY DRILLING COMPANY

upon oath state that the above and foregoing is a true and correct copy of the log of the #1 MEISTRELL "D" well

Subscribed and sworn to before me this 25th day of May 19 59

My Commission Expires: April 14, 1963

Arthur J. Wile
NOTARY PUBLIC