


WELL PLUGGING RECORD

Give All Information Completely  
Make Required Affidavit  
Mail or Deliver Report to:  
Conservation Division  
State Corporation Commission  
212 North Market, Insurance Bldg.  
Wichita, Kansas

ELLIS County. Sec. 9 Twp. 11S Rge. 18W (#) (W)

Location as "NE/CNW/SW" or footage from lines APPROX. SW NE NE  
Lease Owner PETROLEUM, INC.  
Lease Name MEISTRELL "C" Well No. 1  
Office Address ROUTE 2, GREAT BEND, KANSAS  
Character of Well (completed as Oil, Gas or Dry Hole) DRY HOLE  
Date well completed NOVEMBER 3 1959  
Application for plugging filed NOVEMBER 3 1959  
Application for plugging approved NOVEMBER 3 1959  
Plugging commenced NOVEMBER 3 1959  
Plugging completed NOVEMBER 3 1959  
Reason for abandonment of well or producing formation NO PRODUCIBLE ZONES

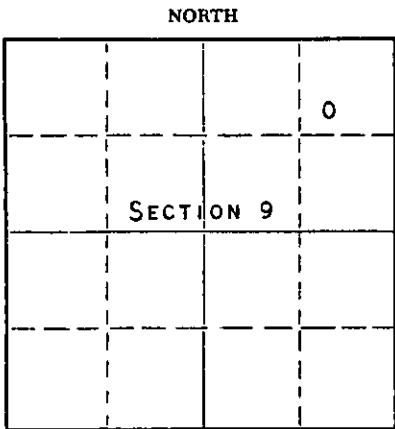

Locate well correctly on above Section Plat

If a producing well is abandoned, date of last production NONE 19  
Was permission obtained from the Conservation Division or its agents before plugging was commenced? YES

Name of Conservation Agent who supervised plugging of this well ELDON PETTY, BOX 326, HAYS, KANSAS  
Producing formation ----- Depth to top ----- Bottom ----- Total Depth of Well 3610 Feet  
Show depth and thickness of all water, oil and gas formations.

OIL, GAS OR WATER RECORDS

CASING RECORD

FORMATION	CONTENT	FROM	TO	SIZE	PUT IN	PULLED OUT
				8-5/8"	248'	NONE

Describe in detail the manner in which the well was plugged, indicating where the mud fluid was placed and the method or methods used in introducing it into the hole. If cement or other plugs were used, state the character of same and depth placed, from \_\_\_\_\_ feet to \_\_\_\_\_ feet for each plug set.

MUD UP WITH HEAVY MUD TO 500' FOLLOWED BY 1/4 SACK HULLS AND A WOODEN PLUG.  
PLACED 20 SACKS OF CEMENT THROUGH DRILL PIPE ON TOP OF PLUG. MUD UP TO 180'  
FOLLOWED BY 1/4 SACK HULLS AND A WOODEN PLUG. PLACED 15 SACKS OF CEMENT THROUGH  
DRILL PIPE ON TOP OF PLUG. MUD UP TO 45' FOLLOWED BY 1/4 SACK HULLS AND A WOODEN  
PLUG. FILLED HOLE TO BASE OF WELL CELLAR WITH 10 SACKS OF CEMENT

RECEIVED  
STATE CORPORATION COMMISSION  
NOV 24 1959  
CONSERVATION DIVISION  
Wichita, Kansas

(If additional description is necessary, use BACK of this sheet)

Name of Plugging Contractor GARVEY DRILLING COMPANY  
Address ROUTE 2, GREAT BEND, KANSAS

STATE OF KANSAS, COUNTY OF BARTON, ss.  
DON SEARLE (employee of owner) or (~~Notary Public~~) of the above-described well, being first duly sworn on oath, says: That I have knowledge of the facts, statements, and matters herein contained and the log of the above-described well as filed and that the same are true and correct. So help me God.

(Signature) Don Searle  
ROUTE 2, GREAT BEND, KANSAS  
(Address)

SUBSCRIBED AND SWORN TO before me this 20TH day of NOVEMBER, 1959

My commission expires APRIL 14, 1963

Arthur J. Miles  
Notary Public.



# WELL LOG

15.051.19446 0000

*R*

COMPANY PETROLEUM, INCORPORATED

SEC. 9 T. 11S R. 18W

FARM MEISTRELL "C" NO. 1


LOC. SW, NE, NE

TOTAL DEPTH 3610'

COUNTY ELLIS CO., KANSAS

COMM. October 24, 1959 COMP. November 3, 1959

CONTRACTOR GARVEY DRILLING COMPANY

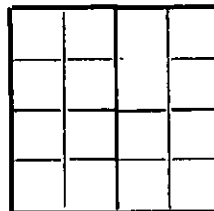

CASING 8 5/8" @ 248' W/175 sax.

ELEVATION 1978' DF

PRODUCTION D & A

FIGURES INDICATE BOTTOM OF FORMATIONS

40	Clay & native rock
90	Clay
120	Sand
180	Shale
248	Blue shale
790	Shale
975	Sand
1310	Shale
1345	Anhydrite
1970	Shale
2250	Shale & lime
3021	Lime & shale
3460	Lime
3484	Lime & conglomerate
3505	Conglomerate & chert
3557	Lime & chert
3585	Conglomerate
3610	Arbuckle Lime
3610	T. D.

STATE OF KANSAS  
 STATE COMMISSION  
 NOV 24 1959  
 CONSERVATION DIVISION  
 Wichita, Kansas

State of KANSAS }  
 County of BARTON } ss:

I, VERNE A. MORRIS of GARVEY DRILLING COMPANY

upon oath state that the above and foregoing is a true and correct copy of the log of the #1 MEISTRELL "C" well.

Verne A. Morris

Subscribed and sworn to before me this 14th day of November 1959

My Commission Expires: April 14, 1963

Arthur J. Wales  
 NOTARY PUBLIC