


Give All Information Completely  
Make Required Affidavit  
Mail or Deliver Report to:  
Conservation Division  
State Corporation Commission  
800 Bitting Building  
Wichita, Kansas

OR  
FORMATION PLUGGING RECORD

Strike out upper line  
when reporting plug-  
ging of formations.

Ellis County. Sec. 6 Twp. 11 Rge. 18 (E) (W) X  
Location as "NE¼NW¼SW¼" or footage from lines... C SE SE SW  
Lease Owner Darby & Eothwell, Inc.  
Lease Name Richards Well No. 1  
Office Address Orpheum Building, Wichita, Kansas  
Character of Well (completed as Oil, Gas or Dry Hole) Abandoned location  
Date well completed February 26 19 45  
Application for plugging filed " 26 19 45  
Application for plugging approved (Verbally) February 26 19 45  
Plugging commenced February 26 19 45  
Plugging completed " " 19 45  
Reason for abandonment of well or producing formation Dakota Water - Skidded Rig  
If a producing well is abandoned, date of last production None 19  
Was permission obtained from the Conservation Division or its agents before plugging was commenced? Yes

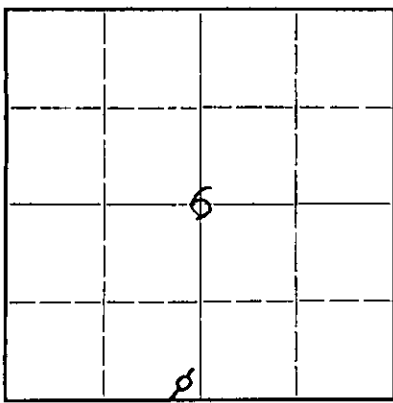


Locate well correctly on above Section Plat

Name of Conservation Agent who supervised plugging of this well Mr. W. H. Kerr  
Producing formation None Depth to top Bottom Total Depth of Well 941' Feet  
Show depth and thickness of all water, oil and gas formations.

OIL, GAS OR WATER RECORDS

CASING RECORD

Formation	Content	From	To	Size	Put In	Pulled Out
				8 5/8"	255'	None

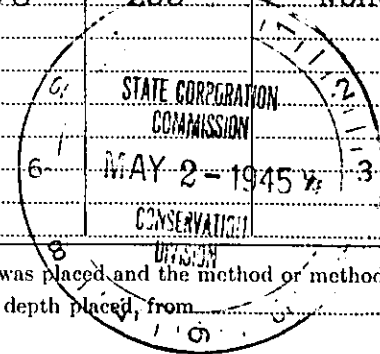

Describe in detail the manner in which the well was plugged, indicating where the mud fluid was placed and the method or methods used in introducing it into the hole. If cement or other plugs were used, state the character of same and depth placed, from feet to feet for each plug set.

Killed Dakota water with heavy mud. Halliburton mixed 100 sacks cement and pumped same in hole leaving 230 feet in pipe. The rest pumped back in formation, pumped plug down 25' and left under pressure until cement set, then put six sacks cement on top of plug.

PLUGGING  
FILE 6-11-48 (W)  
BOOK GE-6-NE-12

(If additional description is necessary, use BACK of this sheet)

Correspondence regarding this well should be addressed to Donald T. Ingling  
Address 708 Fourth National Bank Building, Wichita 2, Kansas

STATE OF Kansas COUNTY OF Sedgwick, ss.  
Donald T. Ingling (employee of owner) or (owner) of the above-described well,

being first duly sworn on oath, says: That I have knowledge of the facts, statements, and matters herein contained and the log of the above-described well as filed and that the same are true and correct. So help me God.

(Signature) Donald T. Ingling

708 Fourth National Bank Bldg.

SUBSCRIBED AND SWORN to before me this 27th day of February 19 45

Leah V. Landrus  
Notary Public.

My commission expires April 10, 1948