


15-135-2111-00-00

STATE OF KANSAS  
STATE CORPORATION COMMISSION  
CONSERVATION DIVISION  
P. O. BOX 17027  
WICHITA, KANSAS 67217

FORM CP-4

WELL PLUGGING RECORD

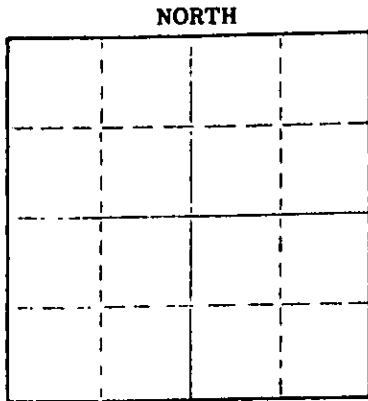

Locate well correctly on above Section Plot

Ness County, Sec 14 Twp. 17S Rge. (E) 24W(W)  
Location as "NE/CNW/SE/SW" or footage from lines NE NE  
Lease Owner Walters Drilling Company  
Lease Name A.P.H. Well No. 1  
Office Address 400 Insurance Building, Wichita, Kansas  
Character of Well (completed as Oil, Gas or Dry Hole) Dry Hole  
Date well completed 11-21-75  
Application for plugging filed 11-21-75  
Application for plugging approved 11-21-75  
Plugging commenced 11-21-75  
Plugging completed 11-21-75  
Reason for abandonment of well or producing formation No commercial quantities of oil or gas encountered.  
If a producing well is abandoned, date of last production 10  
Was permission obtained from the Conservation Division or its agents before plugging was commenced? Yes

Name of Conservation Agent who supervised plugging of this well Leo Massey  
Producing formation \_\_\_\_\_ Depth to top \_\_\_\_\_ Bottom \_\_\_\_\_ Total Depth of Well 4515  
Show depth and thickness of all water, oil and gas formations.

OIL, GAS OR WATER RECORDS

CASING RECORD

FORMATION	CONTENT	FROM	TD	SIZE	PUT IN	PULLED OUT
Surfac Hole	Water	Surface	252	8-5/8"	244'	None

Describe in detail the manner in which the well was plugged, indicating where the mud fluid was placed and the method or methods used in introducing it into the hole. If cement or other plugs were used, state the character of same and depth placed, from \_\_\_\_\_ feet to \_\_\_\_\_ feet for each plug set.

Fluid to 250', 20 sx cement;  
Fluid to 40', 1/2 sx bulls, 10 sx cement.

RECEIVED  
STATE CORPORATION COMMISSION  
11-19-1975  
NOV 19 1975

Name of Plugging Contractor D N B DRILLING, INC.  
Address 701 First National Building  
Wichita, Kansas 67202

STATE OF KANSAS COUNTY OF \_\_\_\_\_

CONSERVATION DIVISION  
ss. Wichita, Kansas

JAMES L. DONELSON (employee of owner) or (owner or operator) of the above-described well, being first duly sworn on oath, says: That I have knowledge of the facts, statements, and matters herein contained and the log of the above-described well as filed and that the same are true and correct. So help me God.

(Signature) James L. Donelson  
701 First Nat'l Bldg., Wichita, Kansas  
(Address)

SUBSCRIBED AND SWORN TO before me this 17th day of November 19 75

My commission expires 8-25-76

Ella Priess  
Notary Public.

Ella Priess  
STATE NOTARY PUBLIC  
Sedgwick County, Kansas  
My Com. Expires Aug. 25, 1976

15-135-2111-00-00

DRILLERS' LOG

WALTERS DRILLING CO.  
No. 1 A.P.H.  
NE NB, Sec. 14-17-24N  

Elev: 2476 K.A.

Commenced: 10-26-75  
Completed: 11-2-75

Surface Casing: 244' of 8-5/8"  
cemented w/175 sx common cement,  
2 1/2 Gal, 3 1/2 cc.. 10-26-75

<u>FORMATION</u>	<u>DEPTH</u>
Surface Hole	0 - 252
Shale	252 - 595
Shale and Sand	595 - 1143
Blaine Anhydrite	1149 - 1151
Shale & Sand	1151 - 1510
Shale & Red Bed	1510 - 1783
Anhydrite	1783 - 1817
Shale	1817 - 2125
Shale & Lime	2125 - 2660
Lime & Shale	2660 - 3070
Lime	3070 - 4515 STD

I do hereby certify that the foregoing statements are true and correct to the best of my knowledge and belief.

D W B DRILLING, INC.

*James L. Donelson*  
JAMES L. DONELSON

STATE OF KANSAS: ss:

Subscribed and sworn to before me this 11th day of November, 1975.

*Ella Priess*  
Ella Priess, Notary Public

*Ella Priess*  
 STATE NOTARY PUBLIC  
 Sedgewick County, Kansas  
 My Com. Expires Aug. 25, 1976