


15-135-21804-00-00

STATE OF KANSAS
STATE CORPORATION COMMISSION

WELL PLUGGING RECORD

Give All Information Completely
Make Required Affidavit
Mail or Deliver Report to
Conservation Division
State Corporation Comm.
245 North Water
Wichita, KS 67202

Ness County, Sec. 14 Twp. 17S Rge. 24 ~~xx~~/W
Location as "NE/CNW/SW" or footage from lines
150' W of C NW NW
Lease Owner Twin Western Resources, Inc.
Lease Name Neyer Well No. 1
Office Address 920 Union Center Bldg.
Character of Well (Completed as Oil, Gas or Dry Hole) dry hole

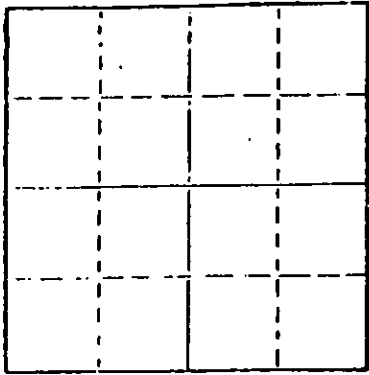

Locate well correctly on above Section Plot

Date Well completed 7-10 1980
Application for plugging filed 7-10 1980
Application for plugging approved 7-10 1980
Plugging commenced 7-10 1980
Plugging completed 7-10 1980
Reason for abandonment of well or producing formation
no commercial quantities of oil or gas encountered
If a producing well is abandoned, date of last production -- 19

Was permission obtained from the Conservation Division or its agents before plugging was commenced? yes

Name of Conservation Agent who supervised plugging of this well Marion Schmidt
Producing formation Depth to top Bottom Total Depth of Well 4600
Show depth and thickness of all water, oil and gas formations.

OIL, GAS OR WATER RECORDS

CASING RECORD

FORMATION	CONTENT	FROM	TO	SIZE	PUT IN	PULLED OUT
surface hole	shale	surf	286'	8-5/8	278'	none

Describe in detail the manner in which the well was plugged, indicating where the mud fluid was placed and the method or methods used in introducing it into the hold. If cement or other plugs were used, state the character of same and depth placed, from feet to feet for each plug set.

plug
Fluid to 900', /70 sx
Fluid to 270', plug, 30 sx
Fluid to 40', plug, 10 sx
Rat hole 5 sx

RECEIVED
STATE CORPORATION COMMISSION
JUL 18 1980
07-18-1980
CONSERVATION DIVISION
Wichita, Kansas

(If additional description is necessary, use BACK of this sheet)

Name of Plugging Contractor DNB DRILLING, INC.

515 R. H. Garvey Building

STATE OF Kansas Wichita, Kansas COUNTY OF Sedgwick, ss.
Ella Priess (employee of owner) or (owner or operator)

of the above-described well, being first duly sworn on oath, says: That I have knowledge of the facts, statements, and matters herein contained and the log of the above-described well as filed and that the same are true and correct. So help me God.

(Signature) Ella Priess
515 R. H. Garvey Bldg., Wichita, Ks. 67202
(Address)

SUBSCRIBED AND SWORN TO before me this 10th day of July, 1980

My commission expires April 30, 1983

Dorothy L. Schmidt
Notary Public.

DOROTHY L. SCHMIDT
STATE NOTARY PUBLIC
Sedgwick County, Kansas
My Appt. Exp. April 30, 1983

15-135-21804-00-00

DRILLER'S LOG

TWIN WESTERN RESOURCES, INC.
No. 1 Neyer
150' W of C NW NW
Sec. 14-17S-24W
Ness Co., Ks.

Commenced: 7-2-80
Completed: 7-11-80

Surface Casing: 278' of 8-5/8"
cemented w/175 ex common, 2% gel,
3% cc

FORMATION

DEPTH

Surface Hole	0 - 286
Shale & Sand	286 - 1153
Blaine	1153 - 1163
Shale, Red Bed & Sand	1163 - 1230
Red Bed & Sand	1230 - 1260
Sand	1260 - 1512
Shale	1512 - 2008
Shale & Lime	2008 - 2965
Lime & Shale	2965 - 3601
Sand, Lime & Shale	3601 - 3631
Lime & Shale	3631 - 4200
Lime	4200 - 4490
Lime & Sand	4490 - 4505
Lime	4585 - 4600

I do hereby certify that the foregoing statements are true and correct to the best of my knowledge and belief.

D N B DRILLING, INC.

Ella Priess
Ella Priess

STATE OF KANSAS: ss:

Subscribed and sworn to before me this 11th day of July, 1980.

RECEIVED
STATE CORPORATION COMMISSION

JUL 18 1980

Dorothy L. Schmidt
Dorothy L. Schmidt, Notary Public
Wichita, Kansas

DOROTHY L. SCHMIDT
STATE NOTARY PUBLIC
Sedgwick County, Kansas
My Appt. Exp. April 30, 1983

07-18-1980