


15-135-21314-00-00

STATE OF KANSAS
STATE CORPORATION COMMISSION

Give All Information Completely
Make Required Affidavit
Mail or Deliver Report to
Conservation Division
State Corporation Commission
245 North Water
Wichita, KS 67202

FORM CP-4

WELL PLUGGING RECORD

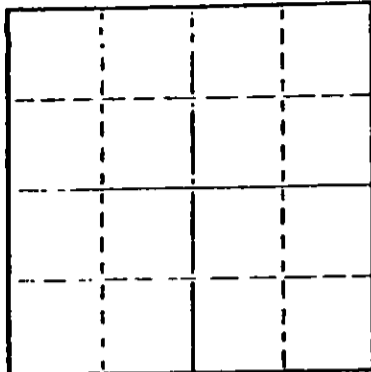

Locate well correctly on above
Section Plot

C NW SE Ness County. Sec. 13 Twp. 17 Rge. 24 ~~W~~ W (W)
Location as "NE/CN/WK/SW2" or footage from lines C NW SE
Lease Owner Walters Drilling Company
Lease Name Lynch 'B' Well No. 1
Office Address 400 Insurance Building, Wichita 67202
Character of Well (completed as Oil, Gas or Dry Hole) Dry Hole
Date well completed April 16 1977
Application for plugging filed April 16 1977
Application for plugging approved April 16 1977
Plugging commenced April 16 1977
Plugging completed April 16 1977
Reason for abandonment of well or producing formation

If a producing well is abandoned, date of last production 19
Was permission obtained from the Conservation Division or its agents before plugging was commenced? Yes

Name of Conservation Agent who supervised plugging of this well Leo F. Massey
Producing formation Depth to top Bottom Total Depth of Well 4470
Show depth and thickness of all water, oil and gas formations.

OIL, GAS OR WATER RECORDS

CASING RECORD

FORMATION	CONTENT	FROM	TO	SIZE	PUT IN	PULLED OUT
	Surface	0	307	8-5/8	yes	no

Describe in detail the manner in which the well was plugged, indicating where the mud fluid was placed and the method or methods used in introducing it into the hole. If cement or other plugs were used, state the character of same and depth placed, from feet to feet for each plug set.

Bottom plug at 720' with 70 sacks 50-50 poz, 6% gel
Middle plug at 240' with 20 sacks 50-50 Poz, 6% gel
Top and bridge at 40' with 10 sacks 50-50 Poz
2 sacks in rathole
Job complete at 4:30 a.m. 4/16/77

(If additional description is necessary, use BACK of this sheet)
Name of Plugging Contractor Slawson Drilling Company, Inc.
Address 408 One Twenty Building, Wichita, Kansas 67202

STATE OF Kansas COUNTY OF Sedgwick
Jim Thatcher (employee of owner) or (owner or operator) of the above-described well, being first duly sworn on oath, says: That I have knowledge of the facts, statements, and matters herein contained and the log of the above-described well as filed and that the same are true and correct. So help me God.

(Signature) Jim Thatcher
Jim Thatcher
408 One Twenty Building, Wichita, Ks. 67202
(Address)

Subscribed and Sworn to before me this 21st day of April 1977

My commission expires January 17, 1981
Mary Lou Taylor
Notary Public.



DRILLERS LOG

OPERATOR: Walters Drilling Company, Inc.
 400 Insurance Building
 Wichita, Kansas 67202

CONTRACTOR: Slawson Drilling Company, Inc.
 408 One Twenty Building
 Wichita, Kansas 67202

LEASE: Lynch 'B' No. 1
 C NW SE Sec. 13-17S-24W
 Ness County, Kansas

COMMENCED 4/7/77

COMPLETED 4/16/77

RTD 4470'

CASING: New 8-5/8" set at 307' with 200 sx cement

0' to 170' Surface hole & shale
 170' to 312' Surface Hole & Shale & shells
 312' to 1192' Shale & Shells
 1192' to 1440' Sand
 1440' to 1750' Shale & Shells
 1750' to 2040' Anhydrite & Shale
 2040' to 2805' Shale & Shells
 2805' to 4175' Lime & Shale
 4175' to 4470' Lime
 4470' RTD

04-22-1977

STATE OF KANSAS

COUNTY OF SEDGWICK

I, Jim Thatcher, of the Slawson Drilling Company, Inc. hereby state that the above and foregoing is a true and accurate copy of the log of the Lynch 'B' No. 1 well.

JIM THATCHER
 Jim Thatcher

Subscribed and sworn to me on this 21st day of April 1977.

Mary Lou Taylor
 Mary Lou Taylor, Notary

My commission expires January 17, 1981

