


Give All Information Completely
Make Required Affidavit
Mail or Deliver Report to:
Conservation Division
State Corporation Commission
P. O. Box 17027
Wichita, Kansas 67217
NORTH

WELL PLUGGING RECORD

Ness County, Sec. 24 Twp. 17 Rge. (E) 24W (W)

Location as "NE/CNW/SW" or footage from lines NE NW SW
Lease Owner DONALD C. SLAWSON
Lease Name Bondurant 'G' Well No. 1
Office Address 200 Douglas Building Wichita, Kansas 67202
Character of Well (completed as Oil, Gas or Dry Hole) Dry Hole
Date well completed May 28, 1981
Application for plugging filed May 28, 1981
Application for plugging approved May 28, 1981
Plugging commenced May 28, 1981
Plugging completed May 28, 1981
Reason for abandonment of well or producing formation Dry Hole

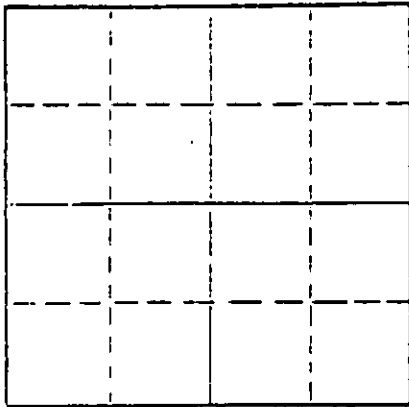

Locate well correctly on above Section Plat

If a producing well is abandoned, date of last production 19
Was permission obtained from the Conservation Division or its agents before plugging was commenced? Yes

Name of Conservation Agent who supervised plugging of this well Marion Schmidt
Producing formation Depth to top Bottom Total Depth of Well 4620 Feet
Show depth and thickness of all water, oil and gas formations.

OIL, GAS OR WATER RECORDS

CASING RECORD

FORMATION	CONTENT	FROM	TO	SIZE	PUT IN	PULLED OUT
		surface	411'	8 5/8"		

Describe in detail the manner in which the well was plugged, indicating where the mud fluid was placed and the method or methods used in introducing it into the hole. If cement or other plugs were used, state the character of same and depth placed, from feet to feet for each plug set.

1st plug @ 900' w/65 sx
2nd plug @ 420' w/30 sx
Solid Bridge @ 40' w/10 sx
5 sx in Rat Hole

(If additional description is necessary, use BACK of this sheet)

Name of Plugging Contractor ALLIED CEMENTING CO., INC.
Address Box 31 Russell, Kansas 67665

STATE OF KANSAS COUNTY OF SEDGWICK
William R. Horigan (employee of owner) or (owner or operator) of the above-described

well, being first duly sworn on oath, says: That I have knowledge of the facts, statements, and matters herein contained and the log of the above-described well as filed and that the same are true and correct. So help me God.

(Signature) William R. Horigan
WILLIAM R. HORIGAN, Operations Engineer
200 Douglas Bldg.
Wichita, Kansas 67202 (Address)

SUBSCRIBED AND SWORN TO before me this 29th day of June 19 81

My commission expires 06/12/82



RECEIVED
JUN 20 1981
07-20-1981
CONSERVATION DIVISION
Wichita, Kansas
Notary Public.

15-135-22032-00-00

WELL LOG

OPERATOR: DONALD C. SLAWSON
 200 DOUGLAS BUILDING
 WICHITA, KANSAS 67202

LEASE: #1 Bondurant 'G'
 NE NW SW Sec. 24-17-24W
 Ness County, Kansas

CONTRACTOR: SLAWSON DRILLING COMPANY, INC.
 200 DOUGLAS BUILDING
 WICHITA, KANSAS 67202

COMMENCED: May 20, 1981

COMPLETED: May 28, 1981

CASING: Surface - 8 5/8" @ 411' w/275 sx 60/40 poz

0 - 420 Surface
 420 - 1730 Shale and shells
 1730 - 2564 Shale
 2564 - 2813 Shale and lime
 2813 - 2996 Shale
 2996 - 4005 Lime and shale
 4005 - 4130 Shale
 4130 - 4545 Lime
 4545 - 4620 Mississippi
 4620 RTD

STATE OF KANSAS)
)
 COUNTY OF SEDGWICK) SS.


I, James C. Remsberg, OF THE SLAWSON DRILLING COMPANY, INC.
 UPON OATH STATE THAT THE ABOVE AND FOREGOING IS A TRUE AND CORRECT COPY OF THE
 LOG OF THE #1 Bondurant 'G' TEST.

James C. Remsberg
 JAMES C. REMSBERG, President

SUBSCRIBED AND SWORN TO BEFORE ME THIS 29th DAY OF June, 1981.

Sherry L. Kendall
 SHERRY L. KENDALL, Notary Public

MY COMMISSION EXPIRES : 06/12/82

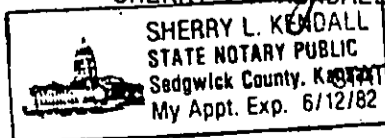

RECEIVED
 STATE CORPORATION COMMISSION
 JUN 20 1981
 07-80-1981
 CONSERVATION DIVISION
 Wichita, Kansas