


15-135-20930-00-01

STATE OF KANSAS
STATE CORPORATION COMMISSION

Give All Information Completely
Make Required Affidavit
Mail or Deliver Report to:
Conservation Division
State Corporation Commission
P. O. Box 17027
Wichita, Kansas 67217
NORTH

WELL PLUGGING RECORD

Ness County, Sec. 21 Twp. 17S Rge. 24 (X) W (W)
Location as "NE/CNW/SW" or footage from lines 200' W of C NE NE
Lease Owner Palomino Petroleum
Lease Name Keilman "C" Well No. 2
Office Address 500 Insurance Bldg.
Character of Well (completed as Oil, Gas or Dry Hole) Dry Hole
Date well completed 9-28 1979
Application for plugging filed 19
Application for plugging approved 19
Plugging commenced 10-27 1979
Plugging completed 7:10 P.M. 10-27 1979
Reason for abandonment of well or producing formation Non-commercial (dry hole)

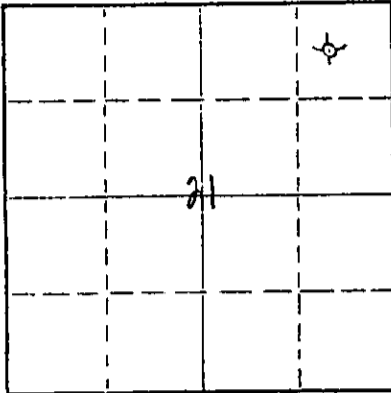

Locate well correctly on above
Section Plat

If a producing well is abandoned, date of last production 19
Was permission obtained from the Conservation Division or its agents before plugging was commenced? Yes

Name of Conservation Agent who supervised plugging of this well Marion Schmidt
Producing formation --- Depth to top --- Bottom --- Total Depth of Well 1115 Feet
Show depth and thickness of all water, oil and gas formations.

OIL, GAS OR WATER RECORDS

CASING RECORD

| FORMATION | CONTENT | FROM | TO | SIZE | PUT IN | PULLED OUT |
|-----------|---------|---------|-----|--------|--------|------------|
| | | Surface | 289 | 8 5/8" | 281 | None |
| | | | | | | |
| | | | | | | |
Describe in detail the manner in which the well was plugged, indicating where the mud fluid was placed and the method or methods used in introducing it into the hole. If cement or other plugs were used, state the character of same and depth placed, from --- feet to --- feet for each plug set.

Zero-200', cement (50 sacks of 50-50 Pozmix)
Retainer wiper plug @ 200'
200'-915', gel (20 sacks gel)
915-1115, cement (50 sacks of 50-50 Pozmix)

11-07-1979

(If additional description is necessary, use BACK of this sheet)
Name of Plugging Contractor Company Operation, Supervisor-Richard Schreiber
Address 500 Insurance Building, Wichita, Kansas 67202

STATE OF KANSAS, COUNTY OF SEDGWICK, ss.
R. W. Watchous, ~~employee of owner~~ (owner) of the above-described well, being first duly sworn on oath, says: That I have knowledge of the facts, statements, and matters herein contained and the log of the above-described well as filed and that the same are true and correct. So help me God.

(Signature) R. W. Watchous
500 Insurance Bldg., Wichita, Kansas 67202
(Address)

SUBSCRIBED AND SWORN TO before me this 6th day of November, 1979

My commission expires March 25, 1980

Deanna D Peterson
Notary Public.
DEANNA D. PETERSON
NOTARY PUBLIC
Sedgwick County, Kansas
My Appt. Exp. 3-25-80