

STATE OF KANSAS
STATE CORPORATION COMMISSION

15-135-21463-00-00

WELL PLUGGING RECORD

Give All Information Completely
Make Required Affidavit
Mail or Deliver Report to
Conservation Division
State Corporation Comm.
245 North Water
Wichita, KS 67202

Ness County, Sec. 21 Twp. 17S Rge. 24W E/W
Location as "NE/CNW $\frac{1}{2}$ SW $\frac{1}{2}$ " or footage from lines
NW SW SW


Lease Owner John Jay Darrah, Jr.
Lease Name Rupp Well No. #1
Office Address Suite 1010, Century Plaza Bldg., Wichita, Ks.
Character of Well (Completed as Oil, Gas or Dry Hole)
dry hole

Date Well completed June 2, 1978 19
Application for plugging filed June 2, 1978 19
Application for plugging approved June 2, 1978 19
Plugging commenced June 2, 1978 19
Plugging completed June 2, 1978 19
Reason for abandonment of well or producing formation
dry hole

If a producing well is abandoned, date of last production 19

Was permission obtained from the Conservation Division or its agents before plugging was commenced? yes

Name of Conservation Agent who supervised plugging of this well Leo Massey
Producing formation Depth to top Bottom Total Depth of Well 4400'
Show depth and thickness of all water, oil and gas formations.

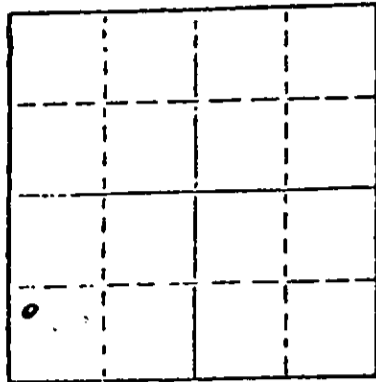

Locate well correctly on above Section Plat

OIL, GAS OR WATER RECORDS

CASING RECORD

FORMATION	CONTENT	FROM	TO	SIZE	PUT IN	PULLED OUT
				8 5/8	267'	

Describe in detail the manner in which the well was plugged, indicating where the mud fluid was placed and the method or methods used in introducing it into the hold. If cement or other plugs were used, state the character of same and depth placed, from _____ feet to _____ feet for each plug set. Hole plugged with 50-50 pozmix, 6% gel, as follows: 70 sacks @ 720', 20 sacks @ 240', Hulls and 10 sacks @ 40'. Plug down at 5:20 a.m., June 2, 1978.

RECEIVED
STATE CORPORATION COMMISSION
SEP 25 1978
CONSERVATION DIVISION
Wichita, Kansas

(If additional description is necessary, use BACK of this sheet)

Name of Plugging Contractor _____

STATE OF KANSAS COUNTY OF BARTON, ss.
Kenneth J. Link (employee of owner) or (owner or operator)
of the above-described well, being first duly sworn on oath, says: That I have knowledge of the facts, statements, and matters herein contained and the log of the above-described well as filed and that the same are true and correct. So help me God.

(Signature) Kenneth J. Link President
P. O. Box 355, Great Bend, Kansas 67530
(Address)

SUBSCRIBED AND SWORN TO before me this 9th day of June, 1978.

Loneita Barry
Loneita Barry Notary Public.

My commission expires 3-28-80.



15-135-21463-00-00

D R I L L E R S L O G

#1 Rupp

CASING RECORD:
6 jts. new 20#
8-5/8" surface
casing.

COMPANY: John Jay Darrah, Jr.
CONTRACTOR: Strata Drilling Company

DESCRIPTION: NW SW SW
 Section 21-17S-24W
 Ness County, Kansas

TOTAL ROTARY
DEPTH: 4400'

COMMENCED: May 26, 1978
COMPLETED: June 2, 1978

ELEVATION: 2382' KB

D & A

<u>FORMATION</u>	<u>FROM</u>	<u>TO</u>	<u>REMARKS</u>
Post rock and sand	0	283	Ran 267' new 20# 8-5/8" surface casing; set and cemented @ 272' with 180 sacks common cement, 2% gel, 3% C.C.; cement circulated. Plug down at 9:30 p.m., May 26, 1978.
Sand, shale	283	1685	
Anhydrite	1685	1715	
Shale	1715	2130	
Shale, lime	2130	3965	
Lime	3965	4070	Ran one drill stem test.
Lime and shale	4070	4265	
Lime	4265	4365	
Lime and shale	4365	4400	

Hole plugged with 50-50 pozmix, 6% gel, as follows: 70 sacks @ 720', 20 sacks @ 240', Hulls and 10 sacks @ 40'. Plug down at 5:20 a.m., June 2, 1978.

RECEIVED
STATE CORPORATION COMMISSION
SEP 25 1978
09-25-1978
CONSULTING DIVISION
Wichita, Kansas

STATE OF KANSAS)
) ss
COUNTY OF BARTON)

I certify that this is a true and correct copy of the above log to the best of my knowledge.

STRATA DRILLING COMPANY

Kenneth J. Link

Kenneth J. Link, President

Sworn to and subscribed before me this 9th day of June, 1978.

My appointment expires 3-28-80.

Loneita Barry

Loneita Barry, Notary Public

