

STATE OF KANSAS
STATE CORPORATION COMMISSION

WELL PLUGGING RECORD

Give All Information Completely
Make Required Affidavit
Mail or Deliver Report to
Conservation Division
State Corporation Comm.
245 North Water
Wichita, KS 67202

Ness County, Sec. 7 Twp. 17S Rge. 24W E/W
Location as "NE/CNW $\frac{1}{4}$ /SW $\frac{1}{4}$ " or footage from lines _____
SW NW


Lease Owner PICKRELL DRILLING COMPANY
Lease Name TILLITSON "A" #1 Well No. _____
Office Address 205 LITWIN BLDG., WICHITA, KS. 67202
Character of Well (Completed as Oil, Gas or Dry Hole) _____

DRY HOLE
Date Well completed 1-17-79 19
Application for plugging filed 1-17-79 19
Application for plugging approved 1-17-79 19
Plugging commenced 1-17-79 19
Plugging completed 1-17-79 19
Reason for abandonment of well or producing formation _____
DRY HOLE

If a producing well is abandoned, date of last production _____ 19

Was permission obtained from the Conservation Division or its agents before plugging was commenced? YES

Name of Conservation Agent who supervised plugging of this well Leo Massey
Producing formation _____ Depth to top _____ Bottom _____ Total Depth of Well 4495
Show depth and thickness of all water, oil and gas formations.

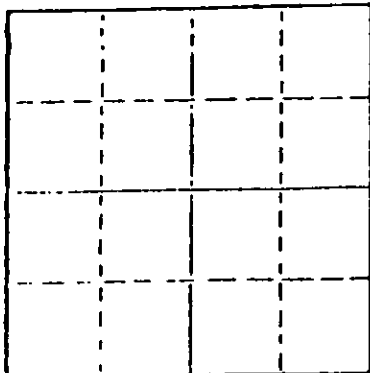

Locate well correctly on above Section Plot

OIL, GAS OR WATER RECORDS

CASING RECORD

FORMATION	CONTENT	FROM	TO	SIZE	PUT IN	PULLED OUT
				8 5/8	210	NONE

Describe in detail the manner in which the well was plugged, indicating where the mud fluid was placed and the method or methods used in introducing it into the hold. If cement or other plugs were used, state the character of same and depth placed, from _____ feet to _____ feet for each plug set.

70 sacks at 720'
20 sakcs at 185'
10 sacks at 40' Comp. 6 a.m. 1-17-79

(If additional description is necessary, use BACK of this sheet)

Name of Plugging Contractor PICKRELL DRILLING COMPANY

STATE OF KANSAS COUNTY OF SEDGWICK, ss.
C. W. SEBITS (employee of owner) or (owner or operator)

of the above-described well, being first duly sworn on oath, says: That I have knowledge of the facts, statements, and matters herein contained and the log of the above-described well as filed and that the same are true and correct. So help me God. BY: C. W. Sebits

(Signature) *[Signature]*
205 LITWIN BLDG., WICHITA, KS. 67202
(Address)

SUBSCRIBED AND SWORN TO before me this 23 day of January, 1979

My commission expires _____

[Signature]
Jo Ann Sarver Notary Public.



01-29-1979

ROTARY DRILLING LOG

COMPANY: PICKRELL DRILLING COMPANY
205 LITWIN BLDG.
WICHITA, KS. 67202

Rotary Drilling Commenced 1-4-79

LOCATION: TILLITSON A #1
SW NW Sec. 7-17S-24W
NESS COUNTY, KANSAS

Rotary Drilling Completed 1-17-79

CONTRACTOR: **PICKRELL DRILLING COMPANY**
Wichita, Kansas

CASING RECORD: Surf. casing 8 5/8" set at 210' with 160sx. Comp. 1-4-79 @ 6:15 P.M.

LOG

(Figures indicate bottom of formation — measurements from top of rotary bushing.)

Topsoil-Postrock	40
Shale	212
Shale	300
Shale	1088
Shale	1530
Shale	1773
Shale	1775
Shale	1782
Shale	1813
Shale	2127
Shale	2415
Shale	2500
Shale & Lime	2763
Lime & Shale	2900
Lime & Shale	3055
Lime & Shale	3246
Lime & Shale	3420
Lime & Shale	3570
Lime & Shale	3797
Lime & Shale	3865
Shale & Lime	3937
Lime & Shale	4003
Lime	4075
Lime	4120
Lime	4185
Lime	4260
Lime	4315
Lime	4375
Lime	4390
Lime	4445
Lime	4458
Lime	4463
Lime	4495

01-29-1979

The undersigned, C. W. Sebitts, Attorney-in-Fact for PICKRELL DRILLING COMPANY, hereby certifies in behalf of said Company, that the above is a true and correct log of the formation encountered in drilling the above well as reflected by the Daily Drilling Reports.

PICKRELL DRILLING COMPANY

By [Signature]
Attorney-in-Fact
C. W. Sebitts

STATE OF KANSAS }
COUNTY OF SEDGWICK } ss.:

On this 23 day of January, 1979, before me the undersigned, a Notary Public, in and for the County and State aforesaid, personally appeared C. W. Sebitts, to me known to be the identical person who subscribed the name of PICKRELL DRILLING COMPANY to the foregoing instrument as its Attorney-in-Fact and acknowledged to me that he executed the same as his free and voluntary act and deed, and as the free and voluntary act and deed of such company, for the uses and purposes therein set forth.

Given under my hand and seal of office the day and year last above written.

My commission expires: _____

[Signature]
Notary Public

Jo Ann Sarver

