


WELL PLUGGING RECORD

Give All Information Completely
Make Required Affidavit
Mail or Deliver Report to:
Conservation Division
State Corporation Commission
211 No. Broadway
Wichita, Kansas

Ness County, Sec. 7 Twp. 17 Rge. 24 ~~25~~ (W)

Location as "NE/CNW/SW" or footage from lines NE NE NW
Lease Owner E. K. Carey Drilling Co., Inc.
Lease Name Tillston Well No. 1
Office Address Box 620, McPherson, Kansas
Character of Well (completed as Oil, Gas or Dry Hole) Dry
Date well completed April 11, 1958
Application for plugging filed April 10, 1958
Application for plugging approved April 10, 1958
Plugging commenced 1:30 AM April 11, 1958
Plugging completed 2:45 AM April 11, 1958
Reason for abandonment of well or producing formation Dry hole

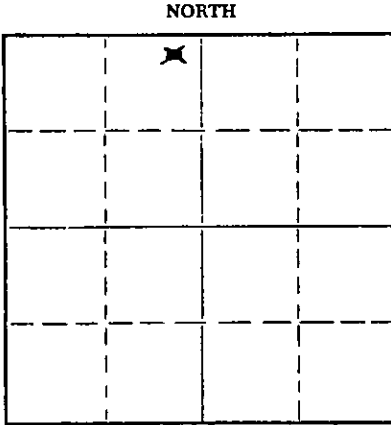

Locate well correctly on above Section Plat

If a producing well is abandoned, date of last production _____ 19____
Was permission obtained from the Conservation Division or its agents before plugging was commenced? Yes

Name of Conservation Agent who supervised plugging of this well C. Lieker, Victoria, Kansas
Producing formation _____ Depth to top _____ Bottom _____ Total Depth of Well 4505 Feet
Show depth and thickness of all water, oil and gas formations.

OIL, GAS OR WATER RECORDS

CASING RECORD

FORMATION	CONTENT	FROM	TO	SIZE	PUT IN	PULLED OUT
				8-5/8	316'	None

Describe in detail the manner in which the well was plugged, indicating where the mud fluid was placed and the method or methods used in introducing it into the hole. If cement or other plugs were used, state the character of same and depth placed, from 315-210 feet to 40-8 feet for each plug set.

Gunned pits, circulated heavy mud on bottom. Layed down half of drill pipe, circulated heavy mud at this point. Layed down all but 316' of drill pipe, ran measuring line and filled with heavy mud to 315'. Set plug and 1/2 sack hulls on top of plug and mixed 35 sacks cement and pumped through drill pipe by Halliburton. Layed down rest of drill pipe and filled with heavy mud to 43', set plug and 1/2 sack hulls and mixed 15 sacks cement and filled to bottom of cellar floor. Through at 2:45 A.M.

(If additional description is necessary, use BACK of this sheet)

Name of Plugging Contractor Capitt Drilling Company, Rotary Tools Rig #4
Address 1005 Central Bldg. Wichita, Kansas

STATE OF Kansas, COUNTY OF McPherson, ss.
Arland Bruce, Superintendent (employee of owner) or (owner or operator) of the above-described well, being first duly sworn on oath, says: That I have knowledge of the facts, statements, and matters herein contained and the log of the above-described well as filed and that the same are true and correct. So help me God.

(Signature) Arland Bruce Supt.
Box 620, McPherson, Kansas
(Address)

SUBSCRIBED AND SWORN to before me this 12th day of April, 19 58

My commission expires November 13, 1960

[Signature]
Notary Public.

0416-1958

PLUGGED
APR 11 7 11 17 1958
BOOK PAGE 931 9

15-135-00110-0000

ROTARY DRILLING LOG

OPERATOR: E. K. Carey Drilling Company, Inc.
TILLITSON NO. 1
NE NE NW Section 7-17S-24W,
Ness County, Kansas

CONTRACTOR: Capitt Drilling, Inc.
COMM: 3/26/58
COMP: 4/11/58

Remarks: Set 5-5/8" surface casing
at 316' cemented with 200 sz. Poz-
mix, 2% C.C.

Formations:

Shale	316'
Shale, Lime Streaks	1250'
Red Bed	1530'
Shale Lime	1707'
Shale & Shells	1795'
Anhydrite	1825'
Shale & Lime	1900'
Shale w/Lime Streaks	2189'
Shale & Lime	2400'
Lime & Shale	2560'
Lime w/Shale Breaks	2745'
Lime	3020'
Lime & Shale	3480'
Lime	4160'
Lime & Shale	4216'
Lime & Shale Streaks	4270'
Lime	4472'
Lime & Chert	4505'
Rotary Total Depth (D&A)	4505'

Geologist Logs:

Coobar	3411 (-1354)
Coronto	3433 (-1376)
...	3451 (-1394)
...	3463 (-1406)
...	4330 (-1387)
...	4404 (-1361)
...	4478 (-1385)

3411 - 4330-4576' or 30' anchor.
Pool open 30 in. with seal log,
closed in 4 min. lost 20 min. for
P. Recovered 10' very slightly
oil and gas.

...	4330-4576' - 16 min
...	4403-4478' "
...	4407-4478' "

We certify the above log is true
and correct to the best of our
knowledge and belief.


CAPITT DRILLING, INC.

R.R. McNicol
R. R. McNicol

Subscribed and sworn to me this 14th day of April, 1958.

My Commission Expires:
September 30, 1959

Darlene May
Darlene May - Notary Public

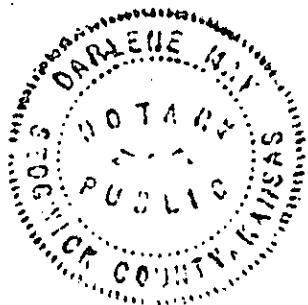

04-16-1958

PLUGGING	
FILE SEC	7 T. 27 R. 24
BOOK PAGE	93 LINE 9