

15-135-20151-00-00

STATE OF KANSAS
STATE CORPORATION COMMISSION

Form CP-4

Give All Information Completely
Make Required Affidavit
Mail or Deliver Report to:
Conservation Division
State Corporation Commission
212 No. Market
Wichita, Kansas

WELL PLUGGING RECORD

Ness County, Sec. 7 Twp. 17S Rge. 24W (E) (W)

Location as "NE/CNW/SW" or footage from lines C SW SE

Lease Owner Walters Drilling Co., et al

Lease Name Sargent-Anderson Well No. 1

Office Address 400 Insurance Building - Wichita, Kansas

Character of Well (completed as Oil, Gas or Dry Hole) Dry Hole

Date well completed 5-27-68 19

Application for plugging filed 5-26-68 19

Application for plugging approved 5-26-68 19

Plugging commenced 5-26-68 19


Plugging completed 5-27-68 19

Reason for abandonment of well or producing formation

commercial quantities of oil not found

If a producing well is abandoned, date of last production 19

Was permission obtained from the Conservation Division or its agents before plugging was commenced? yes

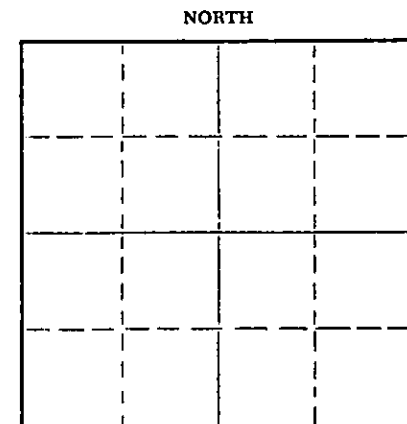

Locate well correctly on above Section Plat

Name of Conservation Agent who supervised plugging of this well Leo Massey

Producing formation _____ Depth to top _____ Bottom _____ Total Depth of Well 4485 Feet

Show depth and thickness of all water, oil and gas formations.

OIL, GAS OR WATER RECORDS

CASING RECORD

FORMATION	CONTENT	FROM	TO	SIZE	PUT IN	PULLED OUT
				8 5/8"	208'	none

Describe in detail the manner in which the well was plugged, indicating where the mud fluid was placed and the method or methods used in introducing it into the hole. If cement or other plugs were used, state the character of same and depth placed, from _____ feet to _____ feet for each plug set.

Bottom Plug @ 720' w/ 70 sacks
2nd Plug @ 180' w/ 20 sacks
Bop Plug @ 40' w/ 10 sacks
Total - 100 sacks - 50/50 posmix 6% gel.

RECEIVED
STATE CORPORATION COMMISSION
JUN 2 1968
CONSERVATION DIVISION
Wichita, Kansas

06-12-1968

(If additional description is necessary, use BACK of this sheet)

Name of Plugging Contractor Walters Drilling Co.

Address 400 Insurance Building - Wichita, Kansas 67202

STATE OF KANSAS, COUNTY OF SEDGWICK, ss.

Robert F. Walters (employee or owner or operator) of the above-described

well, being first duly sworn on oath, says: That I have knowledge of the facts, statements, and matters herein contained and the log of the above-described well as filed and that the same are true and correct. So help me God.

(Signature) Robert F. Walters

400 Insurance Building - Wichita, Kansas 67202

(Address)

Subscribed and sworn to before me this 11th day of June, 1968

My commission expires October 4, 1971

Juanita M. Green
Notary Public.



15-135-20151-0000

DRILLER'S LOG

COMPANY: WALTERS DRILLING CO. ET AL
 400 INSURANCE BUILDING
 WICHITA, KANSAS 67202

WELL NAME: SARGENT-ANDERSON #1
 C SW SE SECTION 7-17S-24W
 NESS COUNTY, KANSAS

CONTRACTOR: WALTERS DRILLING CO.
 400 INSURANCE BUILDING
 WICHITA, KANSAS 67202

ROTARY DRILLING COMMENCED: MAY 27, 1968
 ROTARY DRILLING COMPLETED: JUNE 7, 1968

ELEVATION: 2439 KB

CASING RECORD: 8 5/8" @ 208' w/ 140 sacks cement 2% cal. chloride


LOG

0 - 209	Surface Rock & Clay
209 - 540	Shale
540 - 850	Shale and Shells
850 - 1230	Shale and Sand
1230 - 1315	Sand
1315 - 1770	Shale
1770 - 1800	Anhydrite
1800 - 2015	Shale
2015 - 2410	Shale and Lime
2410 - 2725	Lime and Shale
2725 - 2838	Lime
2838 - 2970	Lime and Shale
2970 - 3163	Lime
3163 - 3700	Lime and Shale
3700 - 3805	Shale and Lime
3805 - 4422	Lime
4422 - 4462	Core
4462 - 4485	Lime and Shale
<u>4485</u>	<u>Rotary Total Depth</u>


RECEIVED
 STATE CORPORATION COMMISSION
 JUN 12 1968
 CONSERVATION DIVISION
 Wichita, Kansas
 06-12-1968

The undersigned, Robert F. Walters, hereby certifies, in behalf of said company that the above log is a true and correct log of the formations encountered in drilling the above well as reflected by the Daily Drilling Reports.

WALTERS DRILLING CO.

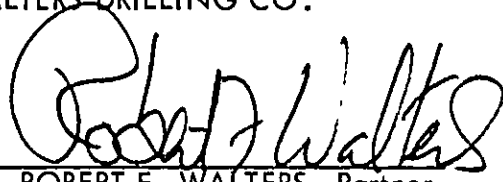BY 
 ROBERT F. WALTERS, Partner

Subscribed and sworn to before me
 this 11th day of June, 1968.

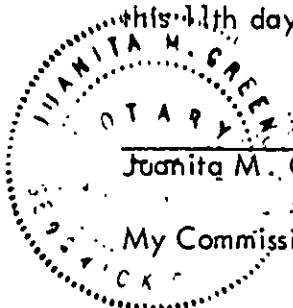

Juanita M. Green, Notary Public

My Commission Expires: October 4, 1971