

WELL PLUGGING RECORD

Give All Information Completely
Make Required Affidavit
Mail or Deliver Report to:
Conservation Division
State Corporation Commission
211 No. Broadway
Wichita, Kansas

Ness County, Sec. 6 Twp. 17S Rge. 24 (E) W (W)

Location as "NE/CNW/SW" or footage from lines C * NW * SE

Lease Owner Manufacturer's Supply Inc.,

Lease Name F.A. Vernilion Well No. B-1

Office Address P.O. Box 484, Great Bend, Kans.

Character of Well (completed as Oil, Gas or Dry Hole) Dry hole

Date well completed 11-14-55 19

Application for plugging filed 5-26-58 19

Application for plugging approved 5-27-58 19


Plugging commenced 6-5-58 19

Plugging completed 6-13-58 19

Reason for abandonment of well or producing formation Excess water

If a producing well is abandoned, date of last production 11-14-58 19

Was permission obtained from the Conservation Division or its agents before plugging was commenced? Yes

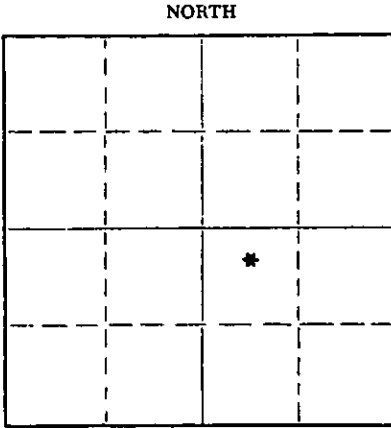

Locate well correctly on above Section Plat

Name of Conservation Agent who supervised plugging of this well Gilbert Leiker

Producing formation Ft Scott Depth to top 4370 Bottom 4404 Total Depth of Well 4496 Feet

Show depth and thickness of all water, oil and gas formations.

OIL, GAS OR WATER RECORDS

CASING RECORD

FORMATION	CONTENT	FROM	TO	SIZE	PUT IN	PULLED OUT
Hobner		3835	3872	10 3/4	360	none
Lansing		3872	4198	7	4496	2660
Ft Scott		4370	4404			
Miss.		4470				

Describe in detail the manner in which the well was plugged, indicating where the mud fluid was placed and the method or methods used in introducing it into the hole. If cement or other plugs were used, state the character of same and depth placed, from _____ feet to _____ feet for each plug set.

Plugged back with sand from 4397' to 4370'. Mixed and dumped 4 sx. cement from 4370 to 4350'. Pull casing. Mud from 4350' to 350'. Set 10' rock bridge from 350' to 340'. Mixed and dumped 20 sx. cement from 340' to 300'. Mudded from 300' to 35'. Set 10' rock bridge from 35' to 25'. Mixed and dumped 10 sx. cement from 25' to base cellar.

RECEIVED
STATE CORPORATION COMMISSION

JUN 17 1958
06-17-1958
CONSERVATION DIVISION
Wichita, Kansas

(If additional description is necessary, use BACK of this sheet)
Name of Plugging Contractor ACE PIPE PULLING CO.
Address BOX 304 GREAT BEND, KS.

STATE OF Kansas COUNTY OF Barton ss.
Charles E. Ridley (employee of owner) or (owner/operator) of the above-described well, being first duly sworn on oath, says: That I have knowledge of the facts, statements, and matters herein contained and the log of the above-described well as filed and that the same are true and correct. So help me God.
(Signature) Charles E. Ridley, Pres
Manufacturer's Supply, Inc.
Box 484, Great Bend, Kansas
(Address)

SUBSCRIBED AND SWORN TO before me this 16th day of June, 19 58

Florence Hancock
Florence Hancock
Notary Public.

My commission expires October 8th, 1959

PLUGGING
FILE SEC. 6 T. 17 R. 24 W
BOOK PAGE 103 LINE 13

15-135-00501-00-00

Ace Pipe Pulling Co.

Post Office Box 304

Telephone 3602

GREAT BEND, KANSAS
May 26, 1958

COMMISSION
MAY 28 1958
05-28-1958
DIVISION
Kansas

State Corporation Commission
Conservation Division
500 Insurance Bldg.
Wichita, Kansas

Gentlemen:

We enclose a copy of the original Log of the F.A. Vermillion "B" #1, C-NW-SE, Sec. 6, Twp. 17, Rge. 24w, as compiled by W. J. Crawford, Petroleum Engineer.

<u>Top</u>	<u>Bottom</u>	<u>Description</u>
0	120	Sand and clay
120	230	Sand and shale
230	975	Shale
975	1375	Shale and shells
1375	1630	Sand and shale
1630	1820	Shale and shells
1820	1840	Anhydrite
1840	2020	Lime, shale and red beds
2020	2150	Lime and red beds
2150	3315	Lime and shale. 2865 lost circulation
3315	3415	Lime, sand and shale
3415	3600	Lime and shale
3600	3731	Lime. 3647' stuck drill pipe
3731	3758	Chalky lime
3758	3830	Lime
3830	3835	Heebner shale
3835	3862	Lime
3862	4198	Lansing-Kansas City Lime
4198	4365	Marmaton section. Lime
4365	4393	Lime and shale. See core analysis
4393	4404	Lime and shale, no shows
4404	4444	Lime
4444	4467	Shale
4467	4496 TD	Lime. Top Mississippi lime @ 4469'.

We failed to enclose this copy with the application.

PLUGGING			
SEC	6	T 17	R 24W
50%K	PAGE	103	LINE 13