

CARD MUST BE TYPED

State of Kansas  
**NOTICE OF INTENTION TO DRILL**  
(see rules on reverse side)

CARD MUST BE SIGNED

Starting Date: ... November 26 1984  
month day year

API Number IS- 135-22,732-00-00

OPERATOR: License # 6177  
Name Foxfire Exploration, Inc.  
Address P. O. Box 6360  
City/State/Zip Los Osos, CA 93402  
Contact Person D. C. Marchant  
Phone (805) 528-6008

SE NW SW Sec 26 Twp 17 S, Rge 24  
(location)  East  West

1650 Ft North from Southeast Corner of Section  
4290 Ft West from Southeast Corner of Section  
(Note: Locate well on Section Plat on reverse side)

CONTRACTOR: License # 8430  
Name Foxfire Drilling Co., Inc.  
City/State WaKeeney, Kansas

Nearest lease or unit boundary line 330 feet.  
County Ness  
Lease Name Schreiber Well# D-1

Well Drilled For: Well Class: Type Equipment:  
 Oil  Swd  Infield  Mud Rotary  
 Gas  Inj  Pool Ext.  Air Rotary  
 OWWO  Expl  Wildcat  Cable

Domestic well within 330 feet:  yes  no  
Municipal well within one mile:  yes  no

If OWWO: old well info as follows:  
Operator  
Well Name  
Comp Date Old Total Depth  
Projected Total Depth 4500 feet  
Projected Formation at TD Mississippian  
Expected Producing Formations Mississippian

Depth to Bottom of fresh water 75 feet  
Lowest usable water formation Dakota  
Depth to Bottom of usable water 970 feet  
Surface pipe by Alternate: 1  2   
Surface pipe to be set 320 feet  
Conductor pipe if any required NA feet  
Ground surface elevation 2446 feet MSL  
This Authorization Expires 5-19-85  
Approved By 11-19-84

I certify that we will comply with K.S.A. 55-101, et seq., plus eventually plugging hole to K.C.C. specifications.


Date 11/13/84 Signature of Operator or Agent Title

Owner  
MHC/KOHE 11/19/84  
Form C-1 4/84

Must be filed with the K.C.C. five (5) days prior to commencing well  
 This card void if drilling not started within six (6) months of date received by K.C.C.

**Important procedures to follow :**

**A Regular Section of Land**  
**1 Mile = 5,280 Ft.**

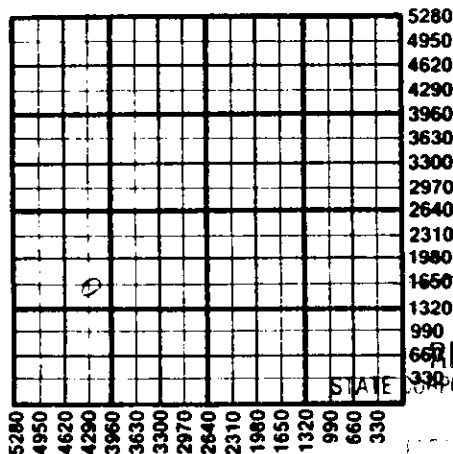

1. Notify District office before setting surface casing.
  2. Set surface casing by circulating cement to the top.
  3. File completion forms ACO-1 with K.C.C. within 90 days of well completion, following instructions on ACO-1, side 1, and including copies of wireline logs.
  4. Notify District office 48 hours prior to old well workover or re-entry.
  5. Prior to plugging, prepare a plugging plan, then obtain agreement from the appropriate district office for an approved plugging plan.
  6. Submit plugging report (CP-4) to K.C.C. after plugging is completed.
  7. Obtain an approved injection docket number before disposing of salt water.
  8. Notify K.C.C. within 10 days when injection commences or terminates.
9. If an alternate 2 completion, cement in the production pipe from below any viable water to surface within 120 days of spud date.

RECEIVED  
 NOV 19 1984  
 CONSERVATION DIVISION  
 WICHITA, KANSAS

**State Corporation Commission of Kansas**  
**Conservation Division**  
**200 Colorado Derby Building**  
**Wichita, Kansas 67202**  
**(316) 263-3238**