


9

Give All Information Completely
Make Required Affidavit
Mail or Deliver Report to:
Conservation Division
State Corporation Commission
212 No. Market
Wichita, Kansas

WELL PLUGGING RECORD

15-115-19255-0000

NORTH

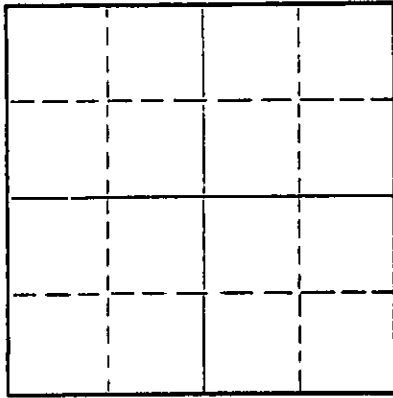

Locate well correctly on above
Section Plat

Location as "NE/CNW/SW" or footage from lines _____
Lease Owner Okmar Oil Co.
Lease Name Schick Well No. 18
Office Address 1130 Wichita Plaza, Wichita, Kansas
Character of Well (completed as Oil, Gas or Dry Hole) _____
Date well completed _____ 19____
Application for plugging filed 10-14-69 19____
Application for plugging approved _____ 19____
Plugging commenced 10-27-69 19____
Plugging completed 10-28-69 19____
Reason for abandonment of well or producing formation _____

If a producing well is abandoned, date of last production _____ 19____
Was permission obtained from the Conservation Division or its agents before plugging was commenced? _____

Name of Conservation Agent who supervised plugging of this well Hugh W. Scott
Producing formation _____ Depth to top _____ Bottom _____ Total Depth of Well 2110' Feet
Show depth and thickness of all water, oil and gas formations.

OIL, GAS OR WATER RECORDS

CASING RECORD

FORMATION	CONTENT	FROM	TO	SIZE	PUT IN	PULLED OUT
				5 1/2"	2106'	1772.30'
				5 5/8"	107'	

Describe in detail the manner in which the well was plugged, indicating where the mud fluid was placed and the method or methods used in introducing it into the hole. If cement or other plugs were used, state the character of same and depth placed, from _____ feet to _____ feet for each plug set.

Made bottom hole plug back with sand to 2400'. Mixed and ran 5 sacks cement thru dump bailer.
Mudded hole to 120', set 10' rock bridge. Mixed and ran 25 sacks cement thru dump bailer. Mudded hole to 40', set 10' rock bridge. Mixed and dumped 10 sacks cement to base of cellar.

RECEIVED
STATE CORPORATION COMMISSION
NOV 3 1969
CONSERVATION DIVISION
Wichita, Kansas

(If additional description is necessary, use BACK of this sheet)

Name of Plugging Contractor Southwest Casing Pulling Co.
Address Box 364, Great Bend, Kansas 67530

STATE OF Kansas, COUNTY OF Barton, ss.
Southwest Casing Pulling Co. (employee of owner) or (owner or operator) of the above-described well, being first duly sworn on oath, says: That I have knowledge of the facts, statements, and matters herein contained and the log of the above-described well as filed and that the same are true and correct. So help me God.

(Signature) [Signature]
Box 364, Great Bend, Kansas
(Address)

SUBSCRIBED AND SWORN to before me this 31 day of October, 19 69

My commission expires October 1972

Sidney D. Miller
Notary Public.



15-115-19255-0000

COPY

WELL LOG BUREAU - KANSAS GEOLOGICAL SOCIETY
412 Union National Bank Bldg., Wichita, Kansas

RING-MAC OIL CO., INC.
Farm Schick No. 8

SEC. 33 T. 17 R. 4E
~~NE~~ NW NW
N2

County Marion
Kansas

Total Depth 2419
Comm. 8-16-41 Comp. 9-3-41
Shot or Treated
Contractor Veeder Supply & Development Co.
Issued 11-22-41

CASING.

Elevation


8 5/8" 107' Cem.
5 1/2" 2406' Cem.

Production Pot. 668 B.

Figures Indicate Bottom of Formations

soil clay and shale	123
lime and shale	242
sdv lime	375
red rock	390
shale and shells	415
shale and red bed	437
lime	478
shale & shells	600
lime & shale	633
red rock	640
shale and shells	792
sdv shale and shells	1075
shale and shells	1360
lime	1385
shale	1420
lime	1435
shale shells	1450
shale	1550
broken lime	1699
sdv shale	1709
shale and redbed	1795
sand	1840
lime	2236
sticky shale & shells	2275
shale & shells	2395

shale	2404
chat	2410
Btm of hole w/rotary	2410
chat	2419
2200' oil fillup	
Total Depth.	

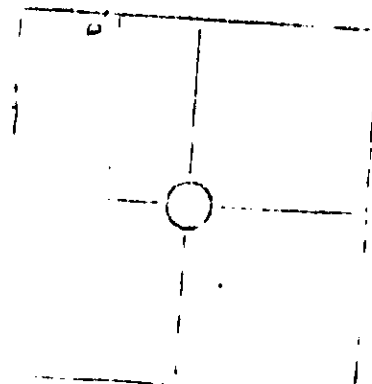

RECEIVED
STATE CORPORATION COMMISSION
OCT 15 1969
CONSERVATION DIVISION
Wichita, Kansas