


Give All Information Completely
Make Required Affidavit
Mail or Deliver Report to:
Conservation Division
State Corporation Commission
212 North Market, Insurance Bldg.
Wichita, Kansas

WELL PLUGGING RECORD

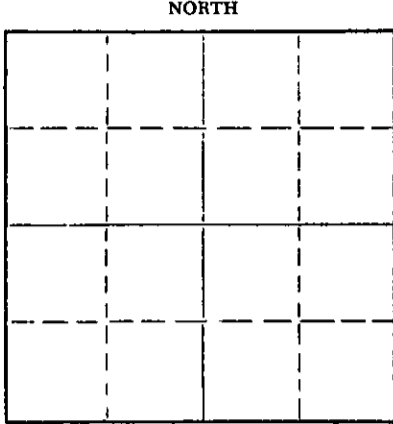

Locate well correctly on above
Section Plat

Location as "NE/CNWxSWx" or footage from lines Ellis County, Sec. 31 Twp. 11S Rge. 18W (E) (W)
Lease Owner Leben Drilling, Inc.
Lease Name Pfeifer "B" Well No. 1
Office Address 905 Central Bldg., Wichita, Kansas
Character of Well (completed as Oil, Gas or Dry Hole) Dry Hole
Date well completed 1-16-60 19
Application for plugging filed 1-16-60 19
Application for plugging approved 1-16-60 19
Plugging commenced 1-16-60 19
Plugging completed 1-16-60 19
Reason for abandonment of well or producing formation Dry Hole

If a producing well is abandoned, date of last production _____ 19
Was permission obtained from the Conservation Division or its agents before plugging was commenced? Yes

Name of Conservation Agent who supervised plugging of this well Eldon Petty
Producing formation _____ Depth to top _____ Bottom _____ Total Depth of Well 3686 Feet
Show depth and thickness of all water, oil and gas formations.

OIL, GAS OR WATER RECORDS

CASING RECORD

FORMATION	CONTENT	FROM	TO	SIZE	PUT IN	PULLED OUT
				8 5/8	236'	

Describe in detail the manner in which the well was plugged, indicating where the mud fluid was placed and the method or methods used in introducing it into the hole. If cement or other plugs were used, state the character of same and depth placed, from _____ feet to _____ feet for each plug set.

1st plug set @ 600' w/ 20 sx. cement.
2nd plug set @ 200' w/ 15 sx. cement.
Top plug set @ 40' w/ 10 sx. cement.


RECEIVED
STATE CORPORATION COMMISSION
JAN 29 1960
CONSERVATION DIVISION
Wichita, Kansas

(If additional description is necessary, use BACK of this sheet)
Name of Plugging Contractor Leben Drilling, Inc.
Address 905 Central Bldg., Wichita, Kansas

STATE OF KANSAS, COUNTY OF SEDGWICK, ss.
Frank Hamlin (employee of owner) or (owner or operator) of the above-described well, being first duly sworn on oath, says: That I have knowledge of the facts, statements, and matters herein contained and the log of the above-described well as filed and that the same are true and correct. So help me God.

(Signature) Frank Hamlin
905 Central Bldg., Wichita, Kansas
(Address)

SUBSCRIBED AND SWORN to before me this 20th day of January, 19 60
My commission expires April 23, 1963
Juanita M. Green Notary Public.

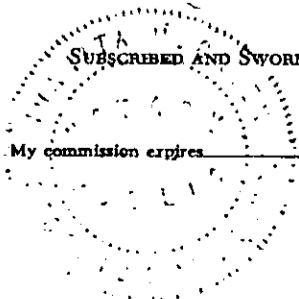

DRILLER'S LOG

COMPANY: LEBEN DRILLING, INC.
 CONTRACTOR: LEBEN DRILLING, INC.
 FARM: PFEIFER "B" #1
 LOCATION: SW SW SW SEC. 31-115-18W
 ELLIS COUNTY, KANSAS
 COMMENCED: 1-6-60
 COMPLETED: 1-16-60

0	30	Rock
30	120	Shale
120	180	Shale
180	220	Sand
220	232	Shale
232	590	Shale, Sand and Shells
590	920	Shale
920	1135	Sand
1135	1245	Shale
1245	1412	Shale and Shells
1412	1442	Anhydrite
1442	1470	Shale and Shells
1470	1945	Shale and Shells
1945	2140	Shale and Shells
2140	2305	Lime and Shale
2305	2420	Lime
2420	2580	Lime and Shale
2580	2720	Lime and Shale
2720	2810	Shale and Lime
2810	3025	Shale and Lime
3025	3185	Shale and Lime
3185	3310	Lime and Shale
3310	3364	Lime and Shale
3364	3430	Lime
3430	3580	Lime
3580	3630	Lime
3630	3686	Lime and Conglomerate
	<u>3686</u>	<u>Total Rotary Depth - D & A</u>

Set 8 5/8" surface casing @ 236' with 150 sacks Sunset cement.

I, Frank Hamlin, do hereby certify that the above and foregoing is a true and correct copy of the log of the Pfeifer "B" #1, located SW SW SW of Section 31-115-18W, Ellis County, Kansas, as reflected by the files of Leben Drilling, Inc.

Frank Hamlin

 FRANK HAMLIN

STATE OF KANSAS)
 COUNTY OF SEDGWICK) ss.

Subscribed and sworn to before me, a Notary Public, in and for Sedgwick County, Kansas, this 20th day of January, 1960.

Juanita M. Green

 Juanita M. Green, Notary Public

My Commission Expires:
 April 23, 1963