


STATE OF KANSAS
STATE CORPORATION COMMISSION

WELL PLUGGING RECORD

Give All Information Completely
Make Required Affidavit
Mail or Deliver Report to:
Conservation Division
State Corporation Commission
800 Bittling Building
Wichita, Kansas

Ellis County. Sec. 20 Twp. 11S Rge. 18 (E) 18 (W)
Location as "NE/CNW/SE/SW" or footage from lines C NE SE NW
Lease Owner Gulf Oil Corporation
Lease Name F. Nixon Well No. 1
Office Address Box 661, Tulas, Oklahoma
Character of Well (completed as Oil, Gas or Dry Hole) Dry hole
Date well completed 8-9 19 54
Application for plugging filed 8-10 19 54
Application for plugging approved 8-14 19 54
Plugging commenced 8-12 19 54
Plugging completed 9-30 19 54
Reason for abandonment of well or producing formation Dry hole

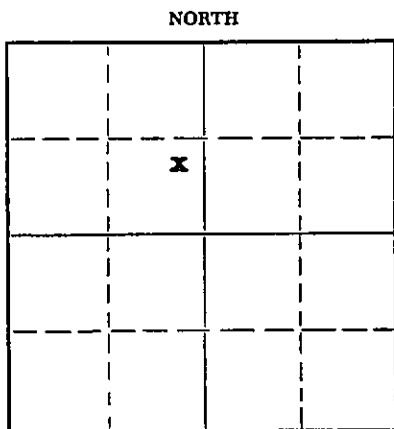

Locate well correctly on above
Section Plat

If a producing well is abandoned, date of last production -0- 19
Was permission obtained from the Conservation Division or its agents before plugging was commenced? Yes

Name of Conservation Agent who supervised plugging of this well Eldon Petty
Producing formation Arbuckle Depth to top 3540' Bottom 3601' Total Depth of Well 3601' Feet
Show depth and thickness of all water, oil and gas formations.

OIL, GAS OR WATER RECORDS

CASING RECORD

FORMATION	CONTENT	FROM	TO	SIZE	PUT IN	PULLED OUT
				8-5/8"	1252'	None

Describe in detail the manner in which the well was plugged, indicating where the mud fluid was placed and the method or methods used in introducing it into the hole. If cement or other plugs were used, state the character of same and depth placed, from _____ feet to _____ feet for each plug set.

Spotted 80 sax Victor Portland cement on bottom and loaded hole to surface with mud.
Capped with 3 wax cement, filled cellar, pits partially filled.

(If additional description is necessary, use BACK of this sheet)
Name of Plugging Contractor H. & H. Drilling Co.
Address Box 54, Wichita, Kansas

STATE OF Kansas, COUNTY OF Rice, ss.
W. H. Duley (employee of owner) or (~~owner~~) of the above-described well, being first duly sworn on oath, says: That I have knowledge of the facts, statements, and matters herein contained and the log of the above-described well as filed and that the same are true and correct. So help me God.

(Signature) W. H. Duley
Box 54, Chase, Kansas
(Address)

SUBSCRIBED AND SWORN TO before me this 8 day of Oct, 1954

My commission expires April 24-1956 _____ Notary Public.

PLUGGING
FILE SEC 20 T 11 R 18
BOOK PAGE 56 LINE 23

10-09-54

