


STATE OF KANSAS  
STATE CORPORATION COMMISSION

Give All Information Completely  
Make Required Affidavit  
Mail or Deliver Report to:  
Conservation Division  
State Corporation Commission  
800 Biting Building  
Wichita, Kansas

WELL PLUGGING RECORD

NORTH

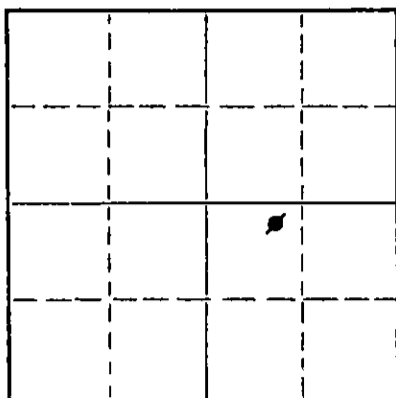

Locate well correctly on above  
Section Plat

Ellis County. Sec. 20 Twp. 11 Rge. 18 (X) W (W)  
Location as "NE/CNWK/SWK" or footage from lines NE NW SE  
Lease Owner C G DRILLING CO.  
Lease Name WASINGER Well No. 1  
Office Address 107 Rule Building, Wichita, Kansas  
Character of Well (completed as Oil, Gas or Dry Hole) oil well  
Date well completed April 3, 1952  
Application for plugging filed July 9 1955  
Application for plugging approved July 9 1955  
Plugging commenced July 10 1955  
Plugging completed July 10 1955  
Reason for abandonment of well or producing formation No longer commercial

If a producing well is abandoned, date of last production April 24 1955  
Was permission obtained from the Conservation Division or its agents before plugging was commenced? Yes

Name of Conservation Agent who supervised plugging of this well Eldon Petty, Box 326, Hays, Kansas  
Producing formation Lansing - K. C. Depth to top 3632 Bottom 3637 Total Depth of Well 3637 Feet  
Show depth and thickness of all water, oil and gas formations.

OIL, GAS OR WATER RECORDS

CASING RECORD

FORMATION	CONTENT	FROM	TO	SIZE	PUT IN	PULLED OUT
				8-5/8"	210.30	none
				5-1/2"	3627.20	none

Describe in detail the manner in which the well was plugged, indicating where the mud fluid was placed and the method or methods used in introducing it into the hole. If cement or other plugs were used, state the character of same and depth placed, from \_\_\_\_\_ feet to \_\_\_\_\_ feet for each plug set.

Put in 15 sacks heavy mud. Set plug. Put in 15 sacks cement.

(If additional description is necessary, use BACK of this sheet)

Name of Plugging Contractor C-G Drilling Co.  
Address 107 Rule Bldg., Wichita, Kansas

STATE OF KANSAS, COUNTY OF SEDGWICK, ss.  
Jay H. Galloway (~~Inspector~~) or (owner or operator) of the above-described well, being first duly sworn on oath, says: That I have knowledge of the facts, statements, and matters herein contained and the log of the above-described well as filed and that the same are true and correct. So help me God.

(Signature) Jay H. Galloway  
107 Rule Bldg., Wichita, Kansas  
(Address)

SUBSCRIBED AND SWORN TO before me this 15th day of July, 1955

My commission expires May 20, 1959

Ticky Jacobs  
Notary Public.

**PLUGGING**  
FILE SEC 20 T 11 R 18  
BOOK PAGE 135 LINE 8

WELL LOG

OPERATOR C-G DRILLING CO. WELL NAME WASINGER #1  
 WELL LOCATION NE/4 NW/4 SE/4 Sec. 20-11-8W. ELLIS COUNTY, KANSAS  
 POOL NAME RIVERVIEW COMMENCEMENT DATE MARCH 21, 1952  
 COMPLETION DATE DRILLING APRIL 3, 1952 WELL PLUGGED JULY 10, 1955

Elevation 2080 rotary bushing  
 All measurements from the top of rotary bushing.

FROM	TO	FORMATION	DEVIATION FROM VERTICAL	REMARKS:
0	140	Sand-Shale		
140	830	Shale-Sand		
830	915	Shale		
915	1050	Sand		
1050	1200	Shale-Sand		
1200	1340	Red Bed		
1340	1377	Red Bed		
1377	1415	Anhydrite		
1415	1980	Shale		
1980	3096	Lime-Shale	0° - 2500'	
3096	3255	Lime	0° - 3000'	DST 3096'
3255	3290	Lime-Shale		
3290	3585	Lime	0° - 3500'	DST 3353'
3585	3622	Lime-Shale		

## CASING LEFT IN HOLE AFTER WELL PLUGGED

210' of 8-5/8" OD Surface Casing.

3627.30' of 5-1/2" OD Oil String of Casing.

STATE OF KANSAS, COUNTY OF SEDGWICK ) ss.

The undersigned certifies that to the best of his knowledge and belief, the above facts are true and correct.

C-G DRILLING CO.

By Jay H. Galloway  
 Jay H. Galloway

Subscribed and sworn to before me this 15th day of July, 1955.

Vicky Jacobs  
 Notary Public

My commission expires 5/20/59

