


WELL PLUGGING RECORD

Give All Information Completely
Make Required Affidavit
Must or Deliver Report to:
Conservation Division
State Corporation Commission
800 Bitting Building
Wichita, Kansas

NORTH

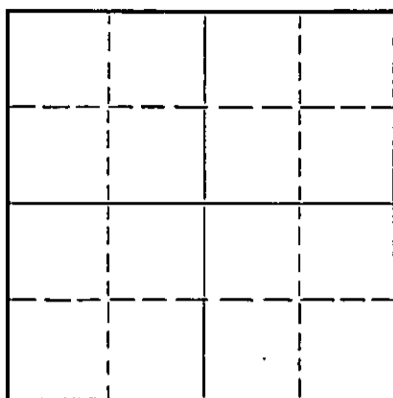

Locate well correctly on above
Section Plat

Ellis County. Sec 20 Twp. 11S. Rge. 18 (W)
Location as "NE/CNW $\frac{1}{4}$ SW $\frac{1}{4}$ " or footage from lines 1650' fr. West, 990' fr. South
Lease Owner Phillips Petroleum Company
Lease Name Hand Well No. 3
Office Address Box 779, Great Bend, Kansas
Character of Well (completed as Oil, Gas or Dry Hole) Dry Hole
Date well completed January 15, 19 55
Application for plugging filed January 6, 19 55
Application for plugging approved January 7, 19 55
Plugging commenced January 12, 19 55
Plugging completed January 15, 19 55
Reason for abandonment of well or producing formation Dry Hole

If a producing well is abandoned, date of last production - 19 -
Was permission obtained from the Conservation Division or its agents before plugging was commenced? Yes

Name of Conservation Agent who supervised plugging of this well Eldon Petty 3676
Producing formation Arbuckle Depth to top 3633 Bottom 3676 Total Depth of Well PB 3356 Feet
Show depth and thickness of all water, oil and gas formations.

OIL, GAS OR WATER RECORDS

CASING RECORD

Formation	Content	From	To	Size	Put In	Pulled Out
Topeka	Dry	3061	3283	9-5/8"	1193.76 OA	None
Heebner	Dry	3283	3302	7"	3655.85 OA	2430'
Toronto	Dry	3302	3326			
Lansing-Kansas City	Dry	3326	3558			
Conglomerate	Dry	3572	3602			
Simpson	Dry	3602	3633			
Arbuckle	Dry	3633	3676			

Describe in detail the manner in which the well was plugged, indicating where the mud fluid was placed and the method or methods used in introducing it into the hole. If cement or other plugs were used, state the character of same and depth placed, from _____ feet to _____ feet for each plug set.

Plugged back from 3356' to 3200' with sand. Dumped 5 ex. cement 3200' to 3176'.
Mudded hole 3176' to 300'. Pushed Howco Plug to 300' and set 5' rock bridge to 295'.
Dumped 30 ex. cement to 250'. Mudded hole 250' to 45'. Set Howco Plug at 45'. Dumped
10 ex. cement in filling to base of cellar. Well plugged and abandoned 3:00 P.M. 1-15-55.

(If additional description is necessary, use BACK of this sheet)

Name of Plugging Contractor West Supply Company
Address Chase, Kansas

01-20-55

STATE OF Kansas, COUNTY OF Barton, ss.
A. J. Willis (employee of owner) ~~not a person connected~~ of the above-described well,

being first duly sworn on oath, says: That I have knowledge of the facts, statements, and matters herein contained and the log of the above-described well as filed and that the same are true and correct. So help me God


(Signature) *A. J. Willis*

Box 779, Great Bend, Kansas (Address)

SUBSCRIBED AND SWORN TO before me this 17th day of January, 19 55

My commission expires November 18, 1957

Notary Public.

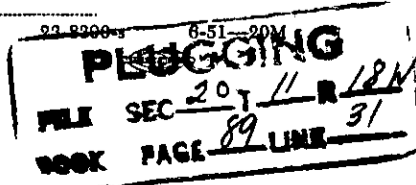

EXPLORATION RECORD

PHILLIPS PETROLEUM COMPANY

Lease _____ Hand (1650' fr. West, 990' fr. South, Sec. 20-11S-18W) Well _____ 3

Formation Name	Top	Base	Remarks
Sand and shale	0	294	
Shale	294	752	
Shale, shells and anhydrite	752	1169	
Shale and anhydrite	1169	1192	
Redbed, shale and anhydrite	1192	1391	
Shale and anhydrite	1391	1520	
Shale and shells	1520	1704	
Salt, shale and shells	1704	1990	
Lime and shale	1990	2367	
Shale	2367	2555	
Lime and shale	2555	3078	
Lime	3078	3490	
Lime and chert	3490	3523	
Lime	3523	3566	
Lime and chert	3566	3633	
Lime	3633	3676	
 <u>FORMATION TOPS:</u>			
Topeka	3061		
Heebner	3283		
Toronto	3302		
Lansing-Kansas City	3326		
Base Kansas City	3558		
Conglomerate	3572		
Simpson	3602		
Arbuckle	3633		
Rotary Total Depth	3638		
Cable Tool Total Depth	3676	PB 3356	

PLUGGING
 FILE SEC. 20-11R-18W
 BOOK PAGE 89 LINE 31