


Give All Information Completely
Make Required Affidavit
Mail or Deliver Report to:
Conservation Division
State Corporation Commission
800 Bitting Building
Wichita, Kansas

15-051-03719-0000
WELL PLUGGING RECORD

NORTH

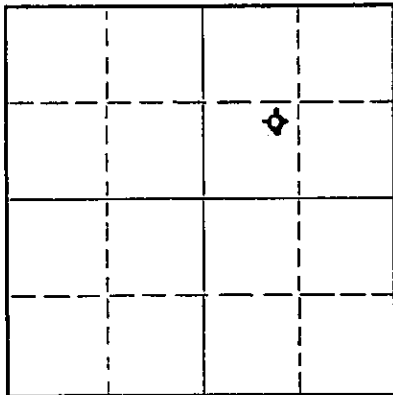

Locate well correctly on above
Section Plat

Ellis County, Sec 20 Twp. 11 Rge. 18 (W) W(W)
Location as "NE/CNW/SW" or footage from lines NE SW NE
Lease Owner C-G Drilling Co.
Lease Name Wasinger Well No. 3
Office Address 107 Rule Building, Wichita, Kansas
Character of Well (completed as Oil, Gas or Dry Hole) Dry Hole
Date well completed 1-18 1954
Application for plugging filed 1-18 1954
Application for plugging approved 1-18 1954
Plugging commenced 1-18 1954
Plugging completed 1-18 1954
Reason for abandonment of well or producing formation Too low structurally

If a producing well is abandoned, date of last production -- 19
Was permission obtained from the Conservation Division or its agents before plugging was commenced? Yes

Name of Conservation Agent who supervised plugging of this well Eldon Petty, Hays, Kansas
Producing formation -- Depth to top -- Bottom -- Total Depth of Well 3670 Feet
Show depth and thickness of all water, oil and gas formations.

OIL, GAS OR WATER RECORDS

CASING RECORD

FORMATION	CONTENT	FROM	TO	SIZE	PUT IN	PULLED OUT
				8-5/8"	190.94	

Describe in detail the manner in which the well was plugged, indicating where the mud fluid was placed and the method or methods used in introducing it into the hole. If cement or other plugs were used, state the character of same and depth placed, from -- feet to -- feet for each plug set.

Filled hole with mud to 185'; set plug; 1/2 sack hulls, 15 sacks cement. Filled hole with mud to 40'; set plug, then filled to top with 10 sacks cement, 1/2 sack hulls.

01-21-54

(If additional description is necessary, use BACK of this sheet)

Name of Plugging Contractor C-G Drilling Co.
Address 107 Rule Building, Wichita, Kansas

STATE OF KANSAS, COUNTY OF SEDGWICK, ss.
Vicky Jacobs (employee of owner) or (DELETED) of the above-described well, being first duly sworn on oath, says: That I have knowledge of the facts, statements, and matters herein contained and the log of the above-described well as filed and that the same are true and correct. So help me God.


(Signature) Vicky Jacobs Office Manager
107 Rule Building, Wichita, Kansas
(Address)

SUBSCRIBED AND SWORN TO before me this 20th day of January, 1954

Barbara Donaldson

My commission expires June 17, 1957

Notary Public.

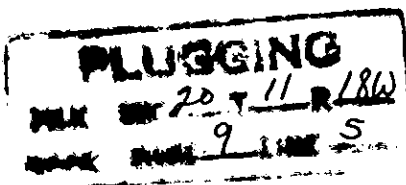

CONTRACTOR'S WELL LOG

OPERATOR C-G Drilling Co. FARM NAME Wasinger #3
 LOCATION NE SW NE, Sec. 20-11-18W
 POOL NAME Riverview COUNTY Ellis STATE Kansas
 COMMENCEMENT DATE January 9, 1954 COMPLETION DATE January 18, 1954

LOG OF WELL

Elevation: 2071 D.F., 2074 R.B.
 All measurements from the top of rdary bushing.

FROM	TO	FORMATION	DEVIATION FROM VERTICAL	REMARKS:
0	191	Shale		
191	675	Shale		
675	775	Sand		
775	850	Shale		
850	1050	Sand		
1050	1100	Shale		
1100	1358	Shale-Shells-Red Bed		
1358	1396	Anhydrite		
1396	1490	Shale-Shells		
1490	1850	Shale	0° - 1500'	
1850	2100	Shale-Shells	0° - 2000'	
2100	2340	Shale-Lime		
2340	2470	Shale-Lime		
2470	2660	Lime-Shale	0° - 2500'	
2660	2790	Lime-Shale		
2790	2948	Shale		
2948	3105	Shale-Lime	0° - 3000'	
3105	3185	Lime-Shale		
3185	3210	Lime-Shale		
3210	3230	Lime-Shale		
3230	3280	Lime-Shale		
3280	3328	Lime-Shale		
3328	3375	Lime-Shale		
3375	3420	Lime-Shale		
3420	3450	Lime		
3450	3510	Lime-Shale		
3510	3580	Lime-Shale		
3580	3635	Lime-Shale		
3635	3670	Lime-Shale		

CASING LEFT IN HOLE AFTER COMPLETION

Ran 190.94' (9 jts) 8-5/8" Surface Casing.

STATE OF KANSAS }
 COUNTY OF SEDGWICK } ss.

The undersigned certifies that to the best of her knowledge and belief, the above facts are true and correct.

C-G DRILLING CO.

By Wicky Jacobs
 OFFICE MANAGER

Subscribed and sworn to before me this 20th day of January 1954.

My commission expires: 6-17 51

PLUGGING
 FILE SEC 20 T 11 R 18W
 BOOK PAGE 9 LINE 5

Barbara Donaldson
 NOTARY PUBLIC