

STATE OF KANSAS
STATE CORPORATION COMMISSION


Give All Information Completely
Make Required Affidavit
Mail or Deliver Report to:
Conservation Division
State Corporation Commission
800 Biting Building
Wichita, Kansas

WELL PLUGGING RECORD

Ellis County, Sec. 20 Twp. 11 Rge. 18 (E) W (W)

Location as "NE/CNWxSWx" or footage from lines SE SE NE
Lease Owner C-G Drilling Co.
Lease Name Wasinger Well No. 4
Office Address 107 Rule Building, Wichita, Kansas
Character of Well (completed as Oil, Gas or Dry Hole) Dry Hole
Date well completed October 23 1954
Application for plugging filed October 23 1954
Application for plugging approved October 23 1954
Plugging commenced October 23 1954
Plugging completed October 23 1954
Reason for abandonment of well or producing formation Too low structurally

NORTH

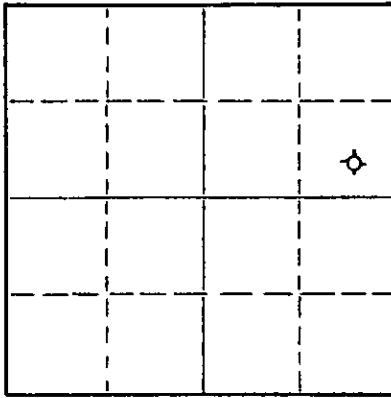

Locate well correctly on above
Section Plat

If a producing well is abandoned, date of last production -- 19
Was permission obtained from the Conservation Division or its agents before plugging was com-
menced? Yes

Name of Conservation Agent who supervised plugging of this well Eldon Petty, Hays, Kansas
Producing formation -- Depth to top -- Bottom -- Total Depth of Well 3523 Feet
Show depth and thickness of all water, oil and gas formations.

OIL, GAS OR WATER RECORDS

CASING RECORD

FORMATION	CONTENT	FROM	TO	SIZE	PUT IN	PULLED OUT
				8-5/8"	179.17	None

Describe in detail the manner in which the well was plugged, indicating where the mud fluid was placed and the method or methods used in introducing it into the hole. If cement or other plugs were used, state the character of same and depth placed, from feet to feet for each plug set.

Filled hole with mud to 173'; set plug;
1/2 sack hulls, 15 sacks cement. Filled
hole with mud to 40'; set plug then filled
to top with 45 sacks cement. 1/2 sack hulls.

(If additional description is necessary, use BACK of this sheet)

Name of Plugging Contractor C-G Drilling Co.
Address 107 Rule Building, Wichita, Kansas

STATE OF KANSAS, COUNTY OF SEDGWICK, ss.
Vicky Jacobs (employee of owner) or (owner) of the above-described well, being first duly sworn on oath, says: That I have knowledge of the facts, statements, and matters herein contained and the log of the above-described well as filed and that the same are true and correct. So help me God.

(Signature) Vicky Jacobs Office Manager

SUBSCRIBED AND SWORN to before me this 28th day of October, 1954

Barbara Donaldson Notary Public

My commission expires June 17, 1957

PLUGGING
FILE SER 20: 11 R 18W
BOOK PAGE 73 LINE 32

10-29-54

CONTRACTOR'S WELL LOG

OPERATOR C-G Drilling FARM NAME Wasinger #4
 LOCATION SE SE NE, Section 20-11-18W
 POOL NAME Riverview COUNTY Ellis STATE Kansas
 COMMENCEMENT DATE October 14, 1954 COMPLETION DATE October 23, 1954

LOG OF WELL

Elevation: 1963 R.B.

All measurements from the top of rotary bushing.

FROM	TO	FORMATION	DEVIATION FROM VERTICAL	REMARKS:
0	70	Shale-Shells		
70	179	Shale-Shells		
179	895	Shale-Shells		
895	925	Sand		
925	1160	Shale-Shells		
1160	1355	Shale-Shells		
1355	1620	Shale-Shells	0° - 1500'	
1620	1900	Lime-Shale		
1900	2050	Lime-Shale	0° - 2000'	
2050	2225	Lime-Shale		
2225	2385	Lime-Shale		
2385	2515	Lime-Shale	0° - 2500'	
2515	2600	Lime-Shale		
2600	2805	Lime-Shale		
2805	2950	Lime-Shale		
2950	3070	Lime-Shale	0° - 3000'	
3070	3150	Lime-Shale		
3150	3220	Lime-Shale		
3220	3290	Lime-Shale		
3290	3355	Lime-Shale		
3355	3410	Lime-Shale		
3410	3499	Lime-Shale		
3499	3518	Lime-Shale	0° - 3500'	
3518	3523	Lime-Shale		DST 3515-18
3523	3523	Lime-Shale		DST 3516-23

CASING LEFT IN HOLE AFTER COMPLETION

Ran 179.17' (6 1/2 ts) of 8-5/8" Surface Casing.

STATE OF KANSAS, COUNTY OF SEDGWICK) ss.

The undersigned certifies that to the best of her knowledge and belief, the above facts are true and correct.

C-G DRILLING CO.

By Wicky Jacobs
Office Manager

Subscribed and sworn to before me this 28th day of October, 1954.

My commission expires:
June 17, 1957

Barbara Donaldson
Notary Public

FILED 20 11 18W
BOOK PAGE 23 32