

WELL PLUGGING RECORD
OR
FORMATION PLUGGING RECORD

Strike out upper line
when reporting plug-
ging off formations.

Give All Information Completely
Make Required Affidavit
Mail or Deliver Report to:
Conservation Division
State Corporation Commission
800 Bittling Building
Wichita, Kansas

Elis

County **S** 20 Twp **11** Rge **18** (E.) (W)

Location as "NE $\frac{1}{4}$ NW $\frac{1}{4}$ SW $\frac{1}{4}$ " or footage from line **C.** of NE $\frac{1}{4}$ of N.E. $\frac{1}{4}$ of S. E. $\frac{1}{4}$

Lease Owner **Central Petroleum Co., Inc.**

Lease Name **Wasinger**

Well No **1**

Office Address **Box 88 Wichita, Kansas**

Character of Well (completed as Oil, Gas or Dry Hole) **dry hole.**

Date, well completed **Nov. 1st, 1941**

19

Application for plugging filed **Nov. 3, 1941**

19

Application for plugging approved **Nov. 4, 1941.**

19

Plugging Commenced **Nov. 4, 1941.**

19

Plugging Completed **Nov. 5, 1941**


19

Reason for abandonment of well or producing formation **Dry hole.**

If a producing well is abandoned, date of last production **none**

19

Was permission obtained from the Conservation Division or its agents before plugging was com-
menced? **Yes. By Mr. C. T. Alexander of Gt. Bend, Kansas**

 

Locate well correctly on above
Section Plot

Name of Conservation Agent who supervised plugging of this well **C. T. Alexander**

Producing formation **Arbuckle** Depth to top **3515** Bottom **3537** Total Depth of Well **3537** Fee

Show depth and thickness of all water, oil and gas formations.

OIL, GAS OR WATER RECORDS

CASING RECORD

Formation	Content	From	To	Size	Put In	Put Out
Arbuckle Lime	Oil and water	3515	3537	5 $\frac{1}{2}$ "	3515	1700'

Describe in detail the manner in which the well was plugged, indicating where the mud fluid was placed and the method or methods used in introducing it into the hole. If cement or other plugs were used, state the character of same and depth placed, from feet to feet for each plug set.

Total Depth **3537'**
5 $\frac{1}{2}$ " Casing set at **3515'**
Hole filled with heavy mud **3537'-3515'**
Cement ~~XXXX~~ **3515'-3495'**
Heavy mud from **3495'-1250'**
Hole bridged at **1250'**
Cement from **1250'-1230'**
Heavy mud from **1230'-375'**
Cement from **375'-355'**
Heavy mud from **355'-30'**
Cement from **30'-8'**

15-051-00917-0000

(If additional description is necessary, use BACK of this sheet)

Correspondence regarding this well should be addressed to **Central Petroleum Co., Inc.**

Address **Box 88 Wichita, Kansas**

STATE OF **Missouri** COUNTY OF **St. Louis** ss.

(employee of owner) or (owner or operator) of the above-described well,
being first duly sworn on oath, says: That I have knowledge of the facts, statements, and matters herein contained and the log of the above-
described well as filed and that the same are true and correct. So help me God.

(Signature)

C. K. ...

(Address)

SUBSCRIBED AND SWORN to before me this ... day of ...

19

Notary Public

WELL LOG BUREAU - KANSAS GEOLOGICAL SOCIETY.
412 Union National Bank Bldg, Wichita, Kansas.

15051-00910000


FALCON-SEABOARD.
Wassinger No. 1

SEC 20 T. 11 R. 18W.
NEC SE

Total Depth. 3538
Comm. 9-17-41 Comp. 10-22-41
Shot or Treated.
Contractor.
Issued 11-15-41

County Ellis.

Rotary 3523
Cable 3538

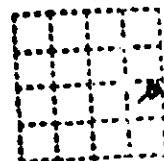

CASING

8 7/8" 1213 Ft. cemented.
5 1/2" 3515' cemented.

Elevation

Production. DRY

Figures Indicate Bottom of Formations.

post rock & blue shale	65	lime	2865
shale	225	shale and shells	2946
sand iron	282	broken lime	2985
shale and shells	390	lime	3137
sand lime	520	lime soft	3146
sand blue shale	712	lime	3460
shale	755	cherty conglomerate	3490
sand	930	Simpson shale & sand	3515
shale	990	Arbuckle lime	3538
red shale and sand	1105	Total Depth.	
sand	1125	Core spotted saturation, bleeding	
shale	1145	oil 3519-3523	
pyrite of iron	1172		
shale red	1195		
anhydrite shell	1212		
shale red	1250		
anhydrite	1290		
shale	1390		
shale and shells	1550		
salt	1795		
shale and shells	1840		
broken lime & shale	1965		
lime	2002		
lime shells & shale	2070		
lime	2078		
lime shells & shale	2166		
cherty lime	2210		
shale	2265		
limo	2292		
shale lime sdy	2364		
sand	2374		
shale and shells	2510		
shale and lime	2720		
sdv shale	2740		
shale and lime	2800		
limo	2832		
broken limo	2850		

I, Edward Swearer, do hereby certify that the above is a true and accurate log of the well drilled at the above location, described as the NEC SE Sec. 20-T. 11, R. 18W, Ellis County, Kansas.

Edward Swearer
Special Representative

Falcon-Seaboard Drilling Company

Subscribed and sworn to before me this 10th day of November, 1941.

Notary Public
Notary Public

My Commission Expires Nov. 3, 1944

20 11 18W
13 13