


Give All Information Completely  
Make Required Affidavit  
Mail or Deliver Report to:  
Conservation Division  
State Corporation Commission  
212 North Market, Insurance Bldg.  
Wichita, Kansas

**WELL PLUGGING RECORD**

Ellis County, Sec. 2 Twp. 11 Rge. 19 (E) (W)  
SW NE SW

Location as "NE/CNWxSWx" or footage from lines \_\_\_\_\_  
Lease Owner Leben Drilling Co.  
Lease Name Herman Well No. 1  
Office Address 905 Central Bldg., Wichita, Kansas  
Character of Well (completed as Oil, Gas or Dry Hole) oil  
Date well completed \_\_\_\_\_ 19\_\_\_\_  
Application for plugging filed 4-21-60 19\_\_\_\_  
Application for plugging approved 4-22-60 19\_\_\_\_  
Plugging commenced 4-21-60 19\_\_\_\_  
Plugging completed 5-2-60 19\_\_\_\_  
Reason for abandonment of well or producing formation \_\_\_\_\_

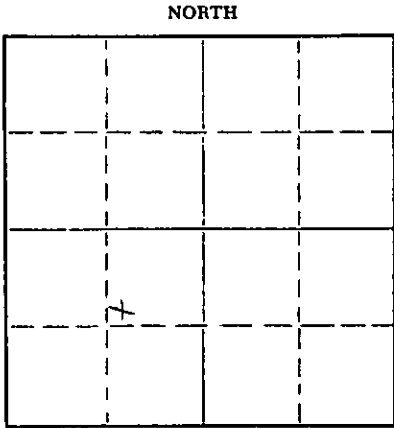

Locate well correctly on above Section Plat

If a producing well is abandoned, date of last production \_\_\_\_\_ 19\_\_\_\_  
Was permission obtained from the Conservation Division or its agents before plugging was commenced? yes

Name of Conservation Agent who supervised plugging of this well \_\_\_\_\_  
Producing formation \_\_\_\_\_ Depth to top \_\_\_\_\_ Bottom \_\_\_\_\_ Total Depth of Well 365 1/2 Feet  
Show depth and thickness of all water, oil and gas formations.

**OIL, GAS OR WATER RECORDS**

**CASING RECORD**

FORMATION	CONTENT	FROM	TO	SIZE	PUT IN	PULLED OUT

Describe in detail the manner in which the well was plugged, indicating where the mud fluid was placed and the method or methods used in introducing it into the hole. If cement or other plugs were used, state the character of same and depth placed, from \_\_\_\_\_ feet to \_\_\_\_\_ feet for each plug set.

sanded back to 3060' mixed and run 5 sacks cement  
mud spotted 20 sacks cement  
mud to 40' set 10' rock bridge mixed and run 10 sacks cement

RECEIVED  
STATE CORPORATION COMMISSION

5-5-60

(If additional description is necessary, use BACK of this sheet)

Name of Plugging Contractor Southwest Casing Pulling Co., Inc.  
Address Box 361, Great Bend, Kansas

STATE OF Kansas, COUNTY OF Barton, ss.  
Southwest Casing Pulling Co., Inc. (employee of owner) or (owner or operator) of the above-described well, being first duly sworn on oath, says: That I have knowledge of the facts, statements, and matters herein contained and the log of the above-described well as filed and that the same are true and correct. So help me God.

(Signature) Roy L. Myers Roy L. Myers, Sec. Treas.  
Box 361, Great Bend, Kansas  
(Address)

SUBSCRIBED AND SWORN TO before me this 4 day of May, 19 60

My commission expires December 18, 1962

Juanita R. Myers  
Notary Public.






WELL LOG BUREAU—KANSAS GEOLOGICAL SOCIETY  
508 East Murdock, Wichita, Kansas

Company- C-G DRILLING CO.  
Farm- Herman No. 1

SEC. 2 T. 11 R. 19W  
SW NE SW

Total Depth. 3651  
Comm. 8-8-54 Comp. 8-15-54  
Shot or Treated.  
Contractor.  
Issued. 10-23-54

County Ellis  
KANSAS

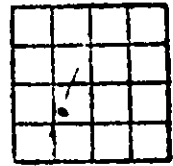

CASING:  
8 5/8" 188.39 cem.

Elevation. 2112

Production. Dry

Figures indicate Bottom of Formations.

shale	188-390
sand & shale	915
sand	1115
redbed	1126
Anhyd.	1164
shale, shells	1175
lime, shale	3651
Total Depth	

Tops: Scout	
Toronto	3291
Lansing	3313
..rbuckle	3626