


STATE OF KANSAS  
STATE CORPORATION COMMISSION

WELL PLUGGING RECORD

Give All Information Completely  
Make Required Affidavit  
Mail or Deliver Report to  
Conservation Division  
State Corporation Comm.  
245 North Water  
Wichita, KS 67202

Ellis County, Sec. 2 Twp. 11S Rge. 19W E/W  
Location as "NE/CNW 1/4 SW 1/4" or footage from lines

SW SW NE  
Lease Owner R. P. Nixon Oil Operations  
Lease Name Billinger Well No. 1  
Office Address Box 589, Russell, Kansas 67665  
Character of Well (Completed as Oil, Gas or Dry Hole)

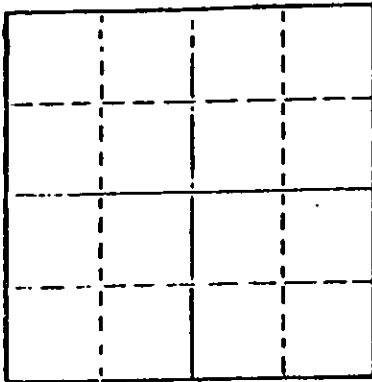

Locate well correctly on above  
Section Plot

Dry Hole  
Date Well completed 3-4-1977  
Application for plugging filed 3-4-1977  
Application for plugging approved 3-4-1977  
Plugging commenced 3-4-1977  
Plugging completed 3-4 2:15 P.M. 1977  
Reason for abandonment of well or producing formation

D & A  
If a producing well is abandoned, date of last production  
None 19

Was permission obtained from the Conservation Division or  
its agents before plugging was commenced? Yes

Name of Conservation Agent who supervised plugging of this well Leo F. Massey  
Producing formation Depth to top Bottom Total Depth of Well 3645'  
Show depth and thickness of all water, oil and gas formations.

OIL, GAS OR WATER RECORDS

8 5/8" casing to 215'

CASING RECORD

FORMATION	CONTENT	FROM	TO	SIZE	PUT IN	PULLED OUT

Describe in detail the manner in which the well was plugged, indicating where the mud fluid  
was placed and the method or methods used in introducing it into the hold. If cement or other  
plugs were used, state the character of same and depth placed, from \_\_\_\_\_ feet to  
\_\_\_\_\_ feet for each plug set.

Filled hole with heavy mud  
Pumped in 20 sacks cement @ 550'  
Pumped in 20 sacks cement @ 215'  
Set plug, Dumped in 1/2 sack hulls, pumped in 10 sacks cement to bottom of cellar.

RECEIVED  
STATE CORPORATION COMMISSION

MAR 15 1977

(If additional description is necessary, use BACK of this sheet)  
Name of Plugging Contractor Revlin Drlg., Inc.  
Box 88, Russell, Kansas 67665

STATE OF Kansas COUNTY OF Russell ss.  
S. C. Lingreen

(employee of owner) or (owner or operator) of the above-described  
well, being first duly sworn on oath, says: That I have knowledge of the facts, statements, and matters herein contained and the log of the  
above-described well as filed and that the same are true and correct. So help me God.

(Signature) Stanley C. Lingreen  
Box 88 Russell, KS  
(Address)

Subscribed and Sworn to before me this 14th day of March, 1977

My commission expires January 29, 1981

Laurnice L. L...  
Notary Public.

