

EXP. 12-13-84  
CARD MUST BE TYPED

State of Kansas  
**NOTICE OF INTENTION TO DRILL**  
(see rules on reverse side)

**CORRECTION**  
CARD MUST BE SIGNED  
7-12-84

Starting Date: ..... 7 ..... 30 ..... 84 .....  
month day year

API Number 15- 115-21, 117-00 00

OPERATOR: License # 5417  
Name Marco Production Co., Inc.  
Address Box 197  
City/State/Zip Marion, Ks. 66861  
Contact Person H. J. Groves  
Phone 316-382-3675

Xc

N/2 SE SE Sec. 9, Twp. 19 S, Rge. 4.  East  
(location)  West

990 Ft North from Southeast Corner of Section  
660 Ft West from Southeast Corner of Section  
(Note: Locate well on Section Plat on reverse side)

CONTRACTOR: License # 5133  
Name Kansas Drilling & Well Serv., Inc.  
City/State Marion, Ks. 66861

Nearest lease or unit boundary line ..... 330 ..... feet.  
County Marion  
Lease Name McCarthy Well # 1

Well Drilled For: Well Class: Type Equipment:  
 Oil  Swd  Infield  Mud Rotary  
 Gas  Inj  Pool Ext.  Air Rotary  
 OWWO  Expl  Wildcat  Cable

Domestic well within 330 feet:  yes  no  
Municipal well within one mile:  yes  no

If OWWO: old well info as follows:

Operator .....  
Well Name .....  
Comp Date ..... Old Total Depth .....  
Projected Total Depth 2400 ..... feet  
Projected Formation at TD Mississippi  
Expected Producing Formations Mississippi

Depth to Bottom of fresh water ..... 100 ..... feet  
Lowest usable water formation Unknown  
Depth to Bottom of usable water ..... 125 ..... feet  
Surface pipe by Alternate: 1  2   
Surface pipe to be set 200 + ..... feet  
Conductor pipe if any required NA ..... feet  
Ground surface elevation 1349 ..... feet MSI  
This Authorization Expires 12-13-84

I certify that we will comply with K.S.A. 55-101, et seq., plus eventually plugging hole to K.C.C. specifications. *was*

Date 7/10/84 Signature of Operator or Agent *H. J. Groves* Title *Pres.*


Approved By 6-7-3-84 *was* 9-18-4E

API # 15-115-21, 117 Correction from 7-1-84 to 7-30-84 and from 9-18-4E to ~~9-18-4E~~

7-19-84

Must be filed with the K.C.C. five (5) days prior to commencing well  
This card void if drilling not started within six (6) months of date received by K.C.C.

**A Regular Section of Land**  
1 Mile = 5,280 Ft.

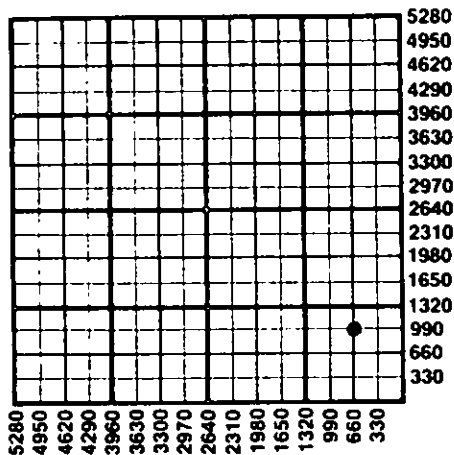

**Important procedures to follow:**

1. Notify District office before setting surface casing.
2. Set surface casing by circulating cement to the top.
3. File completion forms ACO-1 with K.C.C. within 90 days of well completion, following instructions on ACO-1, side 1, and including copies of wireline logs.
4. Notify District office 48 hours prior to old well workover or re-entry.
5. Prior to plugging, prepare a plugging plan, then obtain agreement from the appropriate district office for an approved plugging plan.
6. Submit plugging report (CP-4) to K.C.C. after plugging is completed.
7. Obtain an approved injection docket number before disposing of salt water.
8. Notify K.C.C. within 10 days when injection commences or terminates.
9. If an alternate 2 completion, cement in the production pipe from below any usable water to surface within 120 days of spud date.

RECEIVED  
STATE CORPORATION COMMISSION

JUL 11 1984  
7-11-84  
CONSERVATION DIVISION  
Wichita, Kansas

State Corporation Commission of Kansas  
Conservation Division  
200 Colorado Derby Building  
Wichita, Kansas 67202  
(316) 263-3238