

STATE OF KANSAS
STATE CORPORATION COMMISSION

WELL PLUGGING RECORD

Give All Information Completely
Make Required Affidavit
Mail or Deliver Report to:
Conservation Division
State Corporation Commission
212 No. Market
Wichita, Kansas

Ness County. Sec. 8 Twp. 17S Rge. (E)23 (W)

Location as "NE/CNW%SW%" or footage from lines C SW SE

Lease Owner Mull Drilling Company, Inc.

Lease Name ALBERS Well No. 1

Office Address 1625 Wichita Plaza - Wichita, Kansas

Character of Well (completed as Oil, Gas or Dry Hole) Dry Hole

Date well completed 12-18 1968

Application for plugging filed 12-18 1968

Application for plugging approved 12-18 1968


Plugging commenced 12-18 1968

Plugging completed 10:30 PM 12-18 1968

Reason for abandonment of well or producing formation No oil or gas found
in commercial quantities.

If a producing well is abandoned, date of last production -- 19--

Was permission obtained from the Conservation Division or its agents before plugging was commenced? Yes

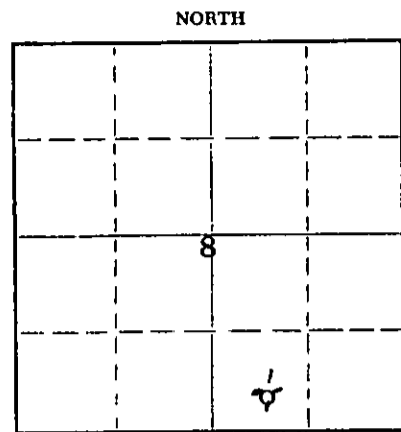

Locate well correctly on above
Section Plat

Name of Conservation Agent who supervised plugging of this well Leo Massey, Hays, Kansas

Producing formation _____ Depth to top _____ Bottom _____ Total Depth of Well 4527 Feet

Show depth and thickness of all water, oil and gas formations.

OIL, GAS OR WATER RECORDS

CASING RECORD

FORMATION	CONTENT	FROM	TO	SIZE	PUT IN	PULLED OUT
				8-5/8"	250'	-0-

Describe in detail the manner in which the well was plugged, indicating where the mud fluid was placed and the method or methods used in introducing it into the hole. If cement or other plugs were used, state the character of same and depth placed, from _____ feet to _____ feet for each plug set.

Cemented with 70 sacks 50-50 Pozmix, 6% gel, at 720'.
Cemented with 20 sacks same at 240'. Set solid bridge
and 10 sacks at 40'.

RECEIVED
STATE CORPORATION COMMISSION
DEC 23 1968
CONSERVATION DIVISION
Wichita, Kansas

(If additional description is necessary, use BACK of this sheet)
Name of Plugging Contractor Rains & Williamson Oil Co., Inc.
Address 1425 Wichita Plaza - Wichita, Kansas

STATE OF KANSAS, COUNTY OF SEDGWICK, ss.
Wilson Rains (employee of owner) or (owner or operator) of the above-described well, being first duly sworn on oath, says: That I have knowledge of the facts, statements, and matters herein contained and the log of the above-described well as filed and that the same are true and correct. So help me God.

(Signature) Wilson Rains Wilson Rains

1425 Wichita Plaza - Wichita, Kansas
(Address)

SUBSCRIBED AND SWORN TO before me this 19 day of December 1968

My commission expires June 30, 1971

Sherry Gish
Sherry Gish Notary Public.

ROTARY DRILLING LOG

15735-20217-0000

Operator: Mull Drilling Company, Inc.
ALBERS #1
C SW SE 8-17S-23W
Ness County, Kansas

Contractor: Rains & Williamson
Oil Co., Inc.
Commenced: 12-5-68
Completed: 12-18-68
Casing: 8-5/8" @ 250'/160 sx.

Formations

Clay, Sand & Chat	134'
Shale	251'
Blue and Grey Shale	585'
Sand	700'
Shale and Red Bed	720'
Shale and Sand and Red Bed	1215'
Shale and Red Bed	1282'
Sand	1475'
Shale and Shells	1787'
Anhydrite	1824'
Shale and Shells	2316'
Shale and Lime	2745'
Lime and Shale	2828'
Shale and Lime	2925'
Shale and Chalky Lime	3090'
Shale and Lime	3740'
Lime	4160'
Lime and Shale	4235'
Lime	4325'
Cherty Lime	4405'
Lime	4435'
Lime and Shale	4465'
Lime	4475'
Cherty Lime	4527'
Rotary Total Depth (D & A)	4527'


RECEIVED
STATE CORPORATION COMMISSION
DEC 23 1968
CONSERVATION DIVISION
Wichita, Kansas

We certify the above log is true and correct to the best of our knowledge and belief.

RAINS & WILLIAMSON OIL CO., INC.


Wilson Rains

Subscribed and sworn to before me, a Notary Public within and for the State of Kansas, County of Sedgwick, this 19 day of December, 1968.

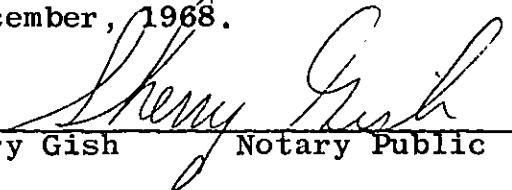
Sherry Gish Notary Public

My Commission Expires: 6-30-71