

STATE OF KANSAS  
STATE CORPORATION COMMISSION

15-135-06376-0001

WELL PLUGGING RECORD

Give All Information Completely  
Make Required Affidavit  
Mail or Deliver Report to  
Conservation Division  
State Corporation Comm.  
245 North Water  
Wichita, KS 67202

Ness County. Sec. 17 Twp. 17 Rge. 23 E/W  
Location as "NE/CNW $\frac{1}{4}$ SW $\frac{1}{4}$ " or footage from lines  
C NW SE


Lease Owner Palomino Petroleum  
Lease Name Oppliger Well No. 4  
Office Address 500 Insurance Bldg., Wichita, Kansas  
Character of Well (Completed as Oil, Gas or Dry Hole) 67202  
oil

Date Well completed April 13 1963  
Application for plugging filed June 25 1979  
Application for plugging approved 19  
Plugging commenced June 28 1979  
Plugging completed July 2 1979

Reason for abandonment of well or producing formation  
depleted  
If a producing well is abandoned, date of last production  
19

Was permission obtained from the Conservation Division or  
its agents before plugging was commenced? yes

Name of Conservation Agent who supervised plugging of this well Marion Schmidt  
Producing formation \_\_\_\_\_ Depth to top \_\_\_\_\_ Bottom \_\_\_\_\_ Total Depth of Well 4475'  
Show depth and thickness of all water, oil and gas formations.

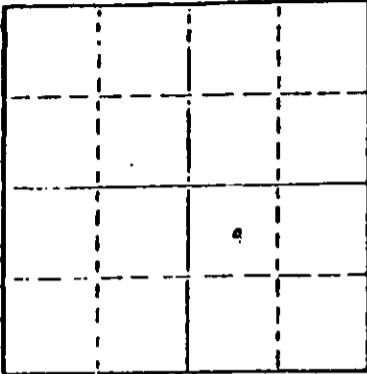

Locate well correctly on above  
Section Plat

OIL, GAS OR WATER RECORDS

CASING RECORD

FORMATION	CONTENT	FROM	TO	SIZE	PUT IN	PULLED OUT
			458'	8 5/8"	458'	none
			4474'	4 1/2"	4474'	397.01

Describe in detail the manner in which the well was plugged, indicating where the mud fluid  
was placed and the method or methods used in introducing it into the hold. If cement or other  
plugs were used, state the character of same and depth placed, from \_\_\_\_\_ feet to  
\_\_\_\_\_ feet for each plug set.

Sun Oil Well Cementing, Inc. plugged well pumping in 2 sacks of hulls, 15  
sacks of gel and 140 sacks of cement.

RECEIVED  
STATE CORPORATION COMMISSION

JUL 11 1979

7-11-79  
CONSERVATION DIVISION  
Wichita, Kansas

(If additional description is necessary, use BACK of this sheet)

Name of Plugging Contractor PIPE PULLERS, INC.  
Box 128, Ellinwood, Kansas 67526


STATE OF KANSAS COUNTY OF BARTON, ss.  
Evelyn Roth (employee of owner) or (owner or operator)

of the above-described well, being first duly sworn on oath, says: That I have knowledge of  
the facts, statements, and matters herein contained and the log of the above-described well  
as filed and that the same are true and correct. So help me God.

(Signature) Evelyn Roth  
Ellinwood, Kansas  
(Address)

SUBSCRIBED AND SWORN TO before me this 10th day of July, 1979

My commission expires

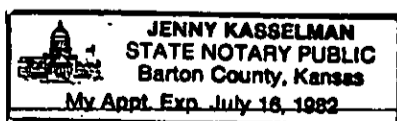

Jenny Kasselmann  
Notary Public.