


Give All Information Completely  
Make Required Affidavit  
Mail or Deliver Report to:  
Conservation Division  
State Corporation Commission  
800 Bittling Building  
Wichita, Kansas

WELL PLUGGING RECORD

Ness County, Sec. 17 Twp. 17S Rge. 23 (E) (W)  
Location as "NE/CNW/SW" or footage from lines C NW SE  
Lease Owner Mull Drilling Company, Inc.  
Lease Name Oppliger Well No. 1  
Office Address 1625 Wichita Plaza, Wichita 2, Kansas  
Character of Well (completed as Oil, Gas or Dry Hole) Oil  
Date well completed April 27 19.63  
Application for plugging filed February 23 19.65  
Application for plugging approved February 23 19.65  
Plugging commenced February 25 19.65  
Plugging completed February 26 19.65  
Reason for abandonment of well or producing formation Low oil production.

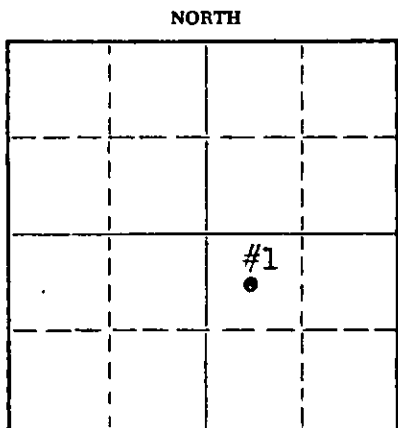

Locate well correctly on above Section Plat

If a producing well is abandoned, date of last production February 28 19.65  
Was permission obtained from the Conservation Division or its agents before plugging was commenced? Yes

Name of Conservation Agent who supervised plugging of this well Eldon Petty  
Producing formation Mississippian Depth to top 4445 Bottom ---- Total Depth of Well 4475 Feet  
Show depth and thickness of all water, oil and gas formations.

OIL, GAS OR WATER RECORDS

CASING RECORD

FORMATION	CONTENT	FROM	TO	SIZE	PUT IN	PULLED OUT
Miss	Oil & wtr	4445	4475	4 1/2"	4474	None
Surface.				8 5/8"	458	None

Describe in detail the manner in which the well was plugged, indicating where the mud fluid was placed and the method or methods used in introducing it into the hole. If cement or other plugs were used, state the character of same and depth placed, from \_\_\_\_\_ feet to \_\_\_\_\_ feet for each plug set.

4 1/2" casing was set at 4474' and cemented w/125 sx cement on 4-15-63. Casing was later recemented at 1200' w/200 sx cement. Casing was not pulled.

To plug, well was filled with mud from bottom to 720' (mixed 30 sx mud). This was followed by 60 sx cement which filled casing from 720' to surface.

RECEIVED  
STATE CORPORATION COMMISSION

MAR 31 1965  
3-31-65

CONSERVATION DIVISION  
Wichita, Kansas

(If additional description is necessary, use BACK of this sheet)

Name of Plugging Contractor Mull Drilling Company, Inc.  
Address 1625 Wichita Plaza, Wichita 2, Kansas

STATE OF KANSAS, COUNTY OF SEDGWICK, ss.  
R. M. Albers (employee of owner) or (~~INDEPENDENT OPERATOR~~) of the above-described well, being first duly sworn on oath, says: That I have knowledge of the facts, statements, and matters herein contained and the log of the above-described well as filed and that the same are true and correct. So help me God.

(Signature) R M Albers  
1625 Wichita Plaza, Wichita 2, Kansas  
(Address)

SUBSCRIBED AND SWORN TO before me this 31st day of March, 1965

My commission expires April 17, 1966 Lola L. Foster Notary Public.



R O T A R Y   D R I L L E R S '   L O G

COMPANY: Mull Drilling Co., Inc.  
Wichita, Kansas

ROTARY DRILLING COMMENCED: 4-1-63

CONTRACTOR: Mull Drilling Co., Inc.  
Wichita, Kansas

ROTARY DRILLING COMPLETED: 4-13-63

CASING RECORD: 458' of 8 5/8" csg.  
                  cemented w/225 ex.  
4474' of 4 1/2" csg. cemented w/125 ex.

LOCATION: #1 Oppliger  
C NW SE Sec. 17-17S-23W  
Ness County, Kansas

(Figures indicate bottom of formation - measurements from top of Rotary Bushing.)

110'	Shale, etc.
1415'	Shale and Clay
1765'	Sandy shale
1805'	Anhydrite
1980'	Sandy Shale & Red Bed
2315'	Sandy shale w/ Lime
3365'	Shale & Lime
3690'	Sandy Lime & Shale
3840'	Chalky Lime & Shale
4219'	Lime w/shale
4372'	Lime
4430'	Lime & Shale
4453'	Conglomerate
4475'	Mississippi and Total Depth

RECEIVED  
STATE CORPORATION COMMISSION

APR 15 1963

CONSERVATION DIVISION  
Wichita, Kansas

I hereby certify that this is a true and correct copy of the above log to the best of my knowledge.

MULL DRILLING COMPANY, INC.

*Joseph B. Brungardt, Jr.*  
Joseph B. Brungardt, Jr.

STATE OF KANSAS     )  
                              ) ss  
COUNTY OF SEDGWICK )

Subscribed to and sworn before me this 24th day of April, 1963.

*Lola L. Foster*  
Lola L. Foster, Notary Public

My commission expires April 17, 1966.

