

WELL PLUGGING RECORD

Give All Information Completely  
Make Required Affidavit  
Mail or Deliver Report to:  
Conservation Division  
State Corporation Commission  
211 No. Broadway  
Wichita, Kansas

Ness County, Sec. 19 Twp. 17S Rge. 23W (E) (W)

Location as "NE/CNW&SW" or footage from lines. c SW SW

Lease Owner Gralapp and Everly

Lease Name Mishler Well No. 1

Office Address P. O. Box 762, Winfield, Kansas 67156

Character of Well (completed as Oil, Gas or Dry Hole) Dry Hole

Date well completed September 24 19 71

Application for plugging filed September 24 19 71

Application for plugging approved September 24 19 71


Plugging commenced September 24 19 71

Plugging completed September 24 19 71

Reason for abandonment of well or producing formation Dry Hole

If a producing well is abandoned, date of last production 19

Was permission obtained from the Conservation Division or its agents before plugging was commenced? Yes

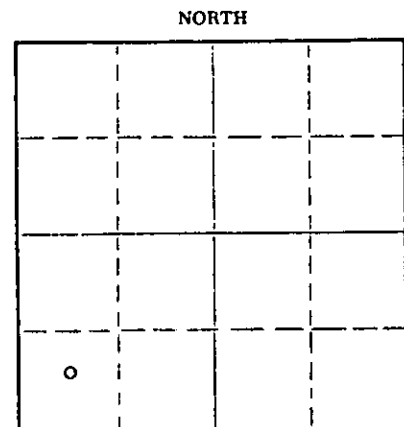

Locate well correctly on above Section Plat

Name of Conservation Agent who supervised plugging of this well Leo F. Massey, Hays, Kansas

Producing formation Depth to top Bottom Total Depth of Well 4552 Feet

Show depth and thickness of all water, oil and gas formations.

OIL, GAS OR WATER RECORDS

CASING RECORD

FORMATION	CONTENT	FROM	TO	SIZE	PUT IN	PULLED OUT
		0	421'	8 5/8"	421'	None

Describe in detail the manner in which the well was plugged, indicating where the mud fluid was placed and the method or methods used in introducing it into the hole. If cement or other plugs were used, state the character of same and depth placed, from feet to feet for each plug set.

Plug: 720'/50 sacks cement  
400'/25 sacks cement  
40'/10 sacks cement

RECEIVED  
STATE CORPORATION COMMISSION  
SEP 30 1971  
CONSERVATION DIVISION  
Wichita, Kansas

(If additional description is necessary, use BACK of this sheet)  
Name of Plugging Contractor Hellar Drilling Company, Inc.  
Address 339 Union Center Bldg., Wichita, Kansas 67202

STATE OF Kansas, COUNTY OF Sedgwick, ss.  
D. L. Hellar, President of Hellar Drilg. Co. (employee of owner) or (owner or operator) of the above-described well, being first duly sworn on oath, says: That I have knowledge of the facts, statements, and matters herein contained and the log of the above-described well as filed and that the same are true and correct. So help me God.

(Signature) D. L. Hellar, President  
339 Union Center Bldg., Wichita, Kansas 67202  
(Address)

Subscribed and sworn to before me this 29th day of September, 19 71  
March 25, 1972.

Notary Public seal for Catherine Darcey, Notary Public, State of Kansas.

Catherine Darcey, Notary Public.

15735-20478 0000

DRILLER'S LOG

COMPANY: Gralapp and Everly, P. O. Box 762, Winfield, Kansas 67156  
 CONTRACTOR: Hellar Drilling Company, Inc., Wichita, Kansas 67202  
 LEASE: #1 Mishler  
 LOCATION: c SW SW 19-17S-23W, Ness County, Kansas  
 COMMENCED: September 13, 1971  
 COMPLETED: September 24, 1971  
 CASING: Set 8 5/8" Surface Casing @ 421'w/350 sacks cement

0-110	Clay & Post Rock
110-1150	Shale
1150-1500	Red Bed & Sand
1500-1787	Shale
1787-1817	Anhydrite
1817-2175	Red Bed & Shells
2175-2311	Shale & Shells
2311-2965	Lime - Shale
2965-3180	Lime & Chalk & Shale
3180-3814	Lime & Shale
3814-4552	Lime - Miss.
4552	Rotary Total Depth

D & A

RECEIVED  
 STATE CORPORATION COMMISSION  
 SEP 30 1971  
 CONSERVATION DIVISION  
 Wichita, Kansas

STATE OF KANSAS )  
 ) SS  
 COUNTY OF SEDGWICK )

I, D. L. Hellar, do hereby certify that the above and foregoing is a true and correct copy of the log of the #1 Mishler, located in c SW SW 19-17S-23W, Ness County, Kansas, as reflected by the files of the Hellar Drilling Company, Inc.

HELLAR DRILLING COMPANY, INC.

By *D. L. Hellar*

Subscribed and sworn to before me, a Notary Public, in and for Sedgwick County, Kansas, this 29th day of September, 1971.

*Catherine Darcy*

My Commission Expires: March 25, 1972.

