


WELL PLUGGING RECORD

Give All Information Completely
Make Required Affidavit
Mail or Deliver Report to:
Conservation Division
State Corporation Commission
211 No. Broadway
Wichita, Kansas

NORTH

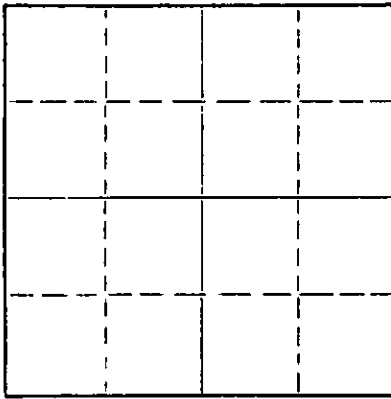

Locate well correctly on above
Section Plat

_____ Ness County. Sec. 16 Twp. 18S Rge. 23 W (E) _____ (W)
Location as "NE/CNW&SW" or footage from lines G NW SW
Lease Owner Hull Drilling Co. Inc.
Lease Name Beardslee Well No. 1
Office Address 670 N. 4th. Natl. Bank Bldg. Wichita, Kansas
Character of Well (completed as Oil, Gas or Dry Hole) Dry Hole.
Date well completed 12-13-62 19____
Application for plugging filed 12-13-62 19____
Application for plugging approved 12-13-62 19____
Plugging commenced 12-13-62 19____
Plugging completed 12-13-62 19____
Reason for abandonment of well or producing formation Non productive.

If a producing well is abandoned, date of last production _____ 19____
Was permission obtained from the Conservation Division or its agents before plugging was commenced? Yes

Name of Conservation Agent who supervised plugging of this well Eldon Petty Hays, Kansas
Producing formation _____ Depth to top _____ Bottom _____ Total Depth of Well 4511 Feet
Show depth and thickness of all water, oil and gas formations.

OIL, GAS OR WATER RECORDS

CASING RECORD

FORMATION	CONTENT	FROM	TO	SIZE	PUT IN	PULLED OUT

Describe in detail the manner in which the well was plugged, indicating where the mud fluid was placed and the method or methods used in introducing it into the hole. If cement or other plugs were used, state the character of same and depth placed, from _____ feet to _____ feet for each plug set.

Plugged hole through drill pipe with bottom plug put at 600' with 20 sacks cement next plug put at 230' with 20 sacks through drill pipe. Next plug put at 40' with 10 sacks cement. Two sacks put in rat hole plugging same.

RECEIVED
STATE CORPORATION COMMISSION

DEC 28 1962

12-28-1962

CONSERVATION DIVISION
Wichita, Kansas

(If additional description is necessary, use BACK of this sheet)

Name of Plugging Contractor Globe cementing Co. pump truck.
Address 6 Great Bend, Kansas

STATE OF KANSAS, COUNTY OF SEDGWICK, ss.
Joseph O. Butts (employee of owner) or (owner or operator) of the above-described well, being first duly sworn on oath, says: That I have knowledge of the facts, statements, and matters herein contained and the log of the above-described well as filed and that the same are true and correct. So help me God.

(Signature) Joseph O. Butts
Wichita, Kansas
(Address)

SUBSCRIBED AND SWORN TO before me this 24th day of December, 19 62

Beth H. Salter
Notary Public.

My commission expires October 16, 1965



