


STATE OF KANSAS
STATE CORPORATION COMMISSION

WELL PLUGGING RECORD

Give All Information Completely
Make Required Affidavit
Mail or Deliver Report to
Conservation Division
State Corporation Comm.
245 North Water
Wichita, KS 67202

Ness County, Sec. 16 Twp. 18S Rge. 23W E/W
Location as "NE/CNW $\frac{1}{4}$ SW $\frac{1}{4}$ " or footage from lines
C SW SE

Lease Owner Walters Drilling Company
Lease Name BEARDSLEE Well No. 1
Office Address 400 Insurance Building, Wichita, Ks
Character of Well (Completed as Oil, Gas or Dry Hole) Dry Hole

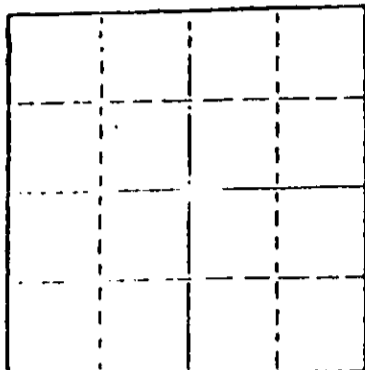

Locate well correctly on above
Section Plat

Date Well completed June 21 1979
Application for plugging filed (verbally) June 21 1979
Application for plugging approved (verbally) June 21 1979
Plugging commenced June 21 1979
Plugging completed June 21 1979

Reason for abandonment of well or producing formation
No commercial quantity of oil or gas encountered
If a producing well is abandoned, date of last production 19

Was permission obtained from the Conservation Division or
its agents before plugging was commenced? Yes

Name of Conservation Agent who supervised plugging of this well Marion Schmidt
Producing formation Depth to top Bottom Total Depth of Well 4440'
Show depth and thickness of all water, oil and gas formations.

OIL, GAS OR WATER RECORDS

CASING RECORD

| FORMATION | CONTENT | FROM | TO | SIZE | PUT IN | PULLED OUT |
|-----------|---------|------|----|------|--------|------------|
| | | | | | | |
| | | | | | | |
| | | | | | | |
| | | | | | | |

Describe in detail the manner in which the well was plugged, indicating where the mud fluid
was placed and the method or methods used in introducing it into the hole. If cement or other
plugs were used, state the character of same and depth placed, from feet to
feet for each plug set.

T.D. 4440'

Set 1st plug at 590' with 60 sacks
2nd plug at 350' with 30 sacks
3rd plug at 40' solid bridge with 10 sacks
rathole with 5 sacks
Cemented with 103 sacks of 50/50 posmix, 6% gel.
Plug was down at 12:30 a.m., 6-21-79

RECEIVED

JUN 21 1979

06-26-1979

(If additional description is necessary, use BACK of this sheet)

Name of Plugging Contractor Abercrombie Drilling, Inc.

STATE OF Kansas COUNTY OF Sedgwick, ss.
Jack L. Partridge, Asst. Sec.-Treas. (employee of owner) or (owner or operator)
of the above-described well, being first duly sworn on oath, says: That I have knowledge of
the facts, statements, and matters herein contained and the log of the above-described well
as filed and that the same are true and correct. So help me God.

(Signature) Jack L. Partridge
801 Union Center, Wichita, Kansas
(Address)

SUBSCRIBED AND SWORN TO before me this 22nd day of June, 19 79



Sherrie L. Brooks
Notary Public.

My commission expires 8-21-82

CONTRACTOR'S WELL LOG 15-135-21633-00-00

OPERATOR: Walters Drilling Company
 CONTRACTOR: Abercrombie Drilling, Inc.
 WELL NAME: Beardslee #1
 LOCATION: C SW SE, Section 16-18S-23W
 Ness County, Kansas
 SPUD DATE: June 12, 1979
 COMPLETION DATE: June 21, 1979

| | | |
|------|------|---------------------|
| 0 | 375 | Shale and sandstone |
| 375 | 1025 | Sand and shale |
| 1025 | 1215 | Sand |
| 1215 | 1580 | Shale |
| 1580 | 1602 | Anhydrite |
| 1602 | 3175 | Shale |
| 3175 | 3638 | Shale and lime |
| 3638 | 4262 | Shale |
| 4262 | 4327 | Shale and lime |
| 4327 | 4440 | Shale |
| | 4440 | Rotary Total Depth |

Spud hole at 9:00 a.m., June 12, 1979. Drilled 375' of 12 1/4" hole. Ran 12 joints of 8-5/8" - 24# 8rd thd casing, new. Set at 375' K.B. with 200 sacks of common cement, 3% Ca.Cl., 2% gel. Pumped plug to 355' K.B. Cement did circulate. Plug was down at 4:00 p.m., June 12, 1979.

T.D. 4440'. Set 1st plug at 590' with 60 sacks, 2nd plug at 350' with 30 sacks, 3rd plug at 40' solid bridge with 10 sacks, rathole with 5 sacks. Cemented with 103 sacks of 50/50 posmix, 6% gel. Plug was down at 12:30 a.m., June 21, 1979.

SAMPLE TOPS:

Anhydrite 1580'
 B/Anhydrite 1602'

RECEIVED
 JUN 21 1979
 06-26-1979

STATE OF KANSAS)
) ss
 COUNTY OF SEDGWICK)

Jack L. Partridge, Assistant Secretary-Treasurer of Abercrombie Drilling, Inc., does hereby state that the above and foregoing is a true and correct copy of the log of the Beardslee #1, C SW SE, Section 16-18S-23W, Ness County, Kansas.

ABERCROMBIE DRILLING, INC.

BY Jack L. Partridge
 Jack L. Partridge
 Assistant Secretary-Treasurer

Subscribed and sworn to before me, a Notary Public, in and for the county and state aforesaid, as of this 22nd day of June, 1979.



Sherrie L. Brooks
 Sherrie Brooks, Notary Public

My commission expires 8-21-82.