


WELL PLUGGING RECORD

Give All Information Completely
Make Required Affidavit
Mail or Deliver Report to:
Conservation Division
State Corporation Commission
800 Bitting Building
Wichita, Kansas

NORTH

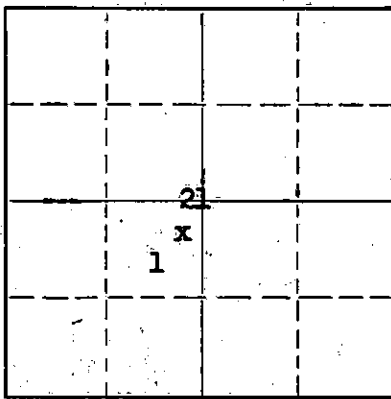

Locate well correctly on above Section Plat

Ellis County, Sec. 21 Twp. 11 Rge. (E) 19 (W)
Location as "NE/CNW $\frac{1}{4}$ /SW $\frac{1}{4}$ " or footage from lines Ctr. NE $\frac{1}{4}$ NE $\frac{1}{4}$ SW $\frac{1}{4}$
Lease Owner Lion Oil Company
Lease Name Sessens Well No. 1
Office Address P. O. Box 639, Pratt, Kansas
Character of Well (completed as Oil, Gas or Dry Hole) Dry Hole

Date well completed 5-17 1952
Application for plugging filed 5-17 1952
Application for plugging approved 5-17 1952
Plugging commenced 5-17 1952
Plugging completed 5-17 1952
Reason for abandonment of well or producing formation Dry Hole

If a producing well is abandoned, date of last production 19
Was permission obtained from the Conservation Division or its agents before plugging was commenced? Yes

Name of Conservation Agent who supervised plugging of this well Eldon Petty
Producing formation Depth to top Bottom Total Depth of Well 3578 Feet
Show depth and thickness of all water, oil and gas formations.

OIL, GAS OR WATER RECORDS

CASING RECORD

Formation	Content	From	To	Size	Put In	Burred Out
				8-5/8"	253'	0'

Describe in detail the manner in which the well was plugged, indicating where the mud fluid was placed and the method or methods used in introducing it into the hole. If cement or other plugs were used, state the character of same and depth placed, from feet to feet for each plug set.

Plug set @ 225' with 70 sacks cement.

RECEIVED
STATE CORPORATION COMMISSION
MAY 29 1952
CONSERVATION DIVISION
Wichita, Kansas

(If additional description is necessary, use BACK of this sheet)
Name of Plugging Contractor R. W. Rine Drilling Company
Address 320 Central Bldg., Wichita, Kansas

STATE OF KANSAS COUNTY OF PRATT ss.
Vernon Hayes (employee of owner) of the above-described well,
being first duly sworn on oath, says: That I have knowledge of the facts, statements, and matters herein contained and the log of the above-described well as filed and that the same are true and correct. So help me God.

(Signature) *Vernon Hayes*
P. O. Box 639, Pratt, Kansas
(Address)

SUBSCRIBED AND SWORN to before me this 26th day of May 1952

Don Deubek
Notary Public

My commission expires August 29, 1955

PLUGGING
FILE SEC 21 T 11 R 19 W
BOOK PAGE 19 LINE 21

NE NE SW,
SEC. 21-115-19W
ELLIS COUNTY, KANSAS

SEDDEN WELL No. 1

CONTRACTOR: THE R. W. RINE DRILLING COMPANY
STARTED: MAY 6, 1952

FINISHED: MAY 17, 1952

LOG

TOP SOIL AND CLAY	0 - 75	
CLAY AND SHALE	75 - 253	8-5/8" @ 253' w/175 SX. w/ 32X. C.C.
CEMENT	253 - 253	
SHALE AND SAND	253 - 700	SYFO @ 500' - OK
SAND AND SHALE	700 - 1160	
SHALE AND SHELLS	1160 - 1285	
ANHYDRITE	1285 - 1320	
SHALE AND SHELLS	1320 - 1385	
SALT SHALE	1385 - 1660	SYFO @ 1500' - OK
SALT AND SHALE	1660 - 1885	
LINE	1885 - 2035	SYFO @ 2000' - 1°
SHALE AND LINE	2035 - 2215	
LINE AND SHALE	2215 - 2610	
LINE	2610 - 2825	
LINE AND SHALE	2825 - 2945	
LINE	2945 - 2981	
LINE AND SHALE	2981 - 3006	SYFO @ 3000' - 1°
LINE	3006 - 3025	
LINE AND SHALE	3025 - 3175	
LINE	3175 - 3230	
LINE	3230 - 3410	
LINE	3410 - 3580	

CORRECTED TO 3578' R.T.D.
D & A @ 3578' - 5-17-52,
PLUGGED BY HALLIBURTON w/70 SX. CEMENT

STATE OF KANSAS }
COUNTY OF SEDDEN } ss.

I, R. N. GREEN, DO HEREBY CERTIFY THAT THE ABOVE IS A TRUE AND ACCURATE LOG OF THE SEDDEN WELL No. 1, LOCATED NE NE SW, SECTION 21-115-19W, ELLIS COUNTY, KANSAS

R. N. Green
ASSISTANT SECRETARY

SUBSCRIBED TO AND SWORN BEFORE ME THIS 24TH DAY OF MAY, 1952.

Leonard Pederson
NOTARY PUBLIC

MY COMMISSION EXPIRES APRIL 20, 1955.

RECEIVED
STATE CONSERVATION COMMISSION
MAY 21 1952
CONSERVATION DIVISION
Wichita, Kansas

PLUGGING
FILE SEC 21T-11R-19W
BOOK PAGE 19 LINE 22