


WELL PLUGGING RECORD

Give All Information Completely
Make Required Affidavit
Mail or Deliver Report to:
Conservation Division
State Corporation Commission
811 No. Broadway
Wichita, Kansas

Location as "NE/CNW/SE/SW" or footage from lines Ellis County, Sec. 21 Twp. 11S Rge. 19W (E) (W)
Lease Owner Don Pratt Oil Operator
Lease Name Soloman Well No. 5
Office Address Box 656, Hays, Kansas 67601
Character of Well (completed as Oil, Gas or Dry Hole) Dry Hole
Date well completed 2-13-65 19
Application for plugging filed 2-13-65 19
Application for plugging approved 2-13-65 19
Plugging commenced 2-13-65 19
Plugging completed 2-13-65 19
Reason for abandonment of well or producing formation Dry Hole

If a producing well is abandoned, date of last production _____ 19____
Was permission obtained from the Conservation Division or its agents before plugging was commenced? yes

Name of Conservation Agent who supervised plugging of this well Eldon Petty, Hays, Kansas
Producing formation _____ Depth to top _____ Bottom _____ Total Depth of Well 3526 Feet
Show depth and thickness of all water, oil and gas formations.

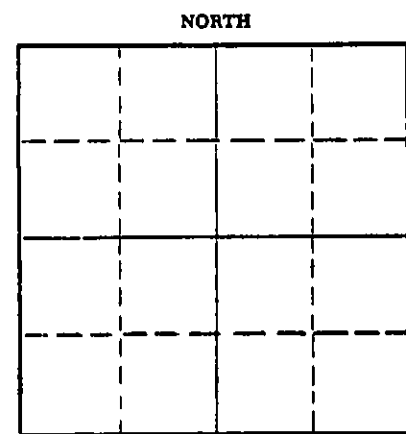

OIL, GAS OR WATER RECORDS

CASING RECORD

FORMATION	CONTENT	FROM	TO	SIZE	PUT IN	PULLED OUT
				8 5/8"	175'	none

Describe in detail the manner in which the well was plugged, indicating where the mud fluid was placed and the method or methods used in introducing it into the hole. If cement or other plugs were used, state the character of same and depth placed, from _____ feet to _____ feet for each plug set.

XXXXXXXXXX

Pushed plug @ 540' cemented with 25 sacks cement
Pushed plug @ 170' cemented with 25 sacks cement
Pushed plug @ 35' cemented with 10 sacks cement

RECEIVED
STATE CORPORATION COMMISSION
FEB 17 1965
CONSERVATION DIVISION
WICHITA, KANSAS

(If additional description is necessary, use BACK of this sheet)
Name of Plugging Contractor Leben Drilling, Inc.
Address Box 486, Great Bend, Kansas 67530

STATE OF KANSAS, COUNTY OF BARTON, ss.
Leslie Kite (employee of owner) or (owner or operator) of the above-described

well, being first duly sworn on oath, says: That I have knowledge of the facts, statements, and matters herein contained and the log of the above-described well as filed and that the same are true and correct. So help me God.

(Signature) Leslie Kite

P. O. Box 486, Great Bend, Kansas
(Address)

SUBSCRIBED AND SWORN TO before me this 16th day of February, 1965.

Mlanda D. Nichols
Notary Public.

My commission expires April 1, 1967

DRILLER'S LOG

COMPANY: Don Pratt Oil Operator
 CONTRACTOR: LEBEN DRILLING, INC.
 FARM: SOLOMAN #5
 LOCATION: NE SE NE Sec. 21-11S-19W
 ELLIS COUNTY, KANSAS
 COMMENCED: 2-6-65
 COMPLETED: 2-13-65

0	70	Clay & Sand
70	175	Shale
175	710	Shale & Sand
710	965	Sand
965	1258	Red Rock Sand
1258	1300	Anhydrite
1300	1800	Shale & Shells
1800	2225	Lime & Shale
2225	2575	Lime
2575	2980	Shale & Lime
2980	3521	Lime
3521	3526	Arbuckle
	<u>3526</u>	<u>Rotary Total Depth - D. & A.</u>

FEB 17 1965

 Set 8 5/8" used surface casing @ 175' cemented with 150 sacks GL3

I, Leslie Kite, do hereby certify that the above and foregoing is a true and correct copy of the log of the Soloman #5 well, located NE SE NE of Section 21, Township 11 South, Range 19 West, Ellis County, Kansas, as reflected by the files of Leben Drilling, Inc.

Leslie Kite

 Leslie Kite

STATE OF KANSAS)
) SS
 COUNTY OF BARTON)

Subscribed and sworn to before me, a Notary Public, in and for Barton County, Kansas, this 16th day of February, 1965.

Ulanda Nichols

 Ulanda Nichols

My Commission Expires
 April 1, 1967