


STATE OF KANSAS
STATE CORPORATION COMMISSION

Give full information completely
Make Required Affidavit
Mail or Deliver Report to:
Conservation Division
State Corporation Commission
211 No. Broadway
Wichita, Kansas

WELL PLUGGING RECORD

NORTH

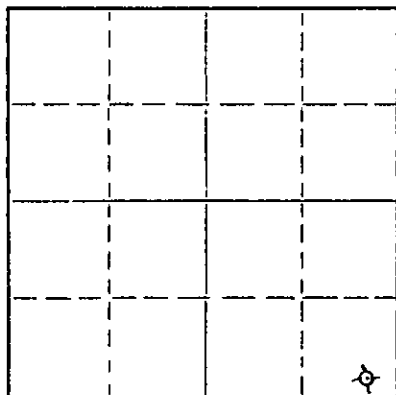

Locate well correctly on above
Section Plat

Ellis County. Sec. 4 Twp. 11 Rge. 19 (E) W (W)
Location as "NE/CNWxSWx" or footage from lines SE SE SE
Lease Owner C-G Drilling Co.
Lease Name Forgue Well No. 1
Office Address 107 Rule Bldg., Wichita, Kansas
Character of Well (completed as Oil, Gas or Dry Hole) Dry Hole
Date well completed August 29 19 56
Application for plugging filed August 29 19 56
Application for plugging approved August 29 19 56
Plugging commenced August 30 19 56
Plugging completed August 30 19 56
Reason for abandonment of well or producing formation Too low structurally

If a producing well is abandoned, date of last production _____ 19____
Was permission obtained from the Conservation Division or its agents before plugging was com-
menced? Yes

Name of Conservation Agent who supervised plugging of this well Eldon Petty
Producing formation _____ Depth to top _____ Bottom _____ Total Depth of Well 3577 Feet
Show depth and thickness of all water, oil and gas formations.

OIL, GAS OR WATER RECORDS

CASING RECORD

FORMATION	CONTENT	FROM	TO	SIZE	PUT IN	PULLED OUT
				8-5/8"	185'	none

Describe in detail the manner in which the well was plugged, indicating where the mud fluid was placed and the method or methods used in introducing it into the hole. If cement or other plugs were used, state the character of same and depth placed, from _____ feet to _____ feet for each plug set.

Filled hole with heavy mud to 180. Set plug. Put in 1/2 Sack Hulls and 15 sacks cement. Filled with heavy mud to 40'. Set plug. Filled to top with 1/2 sack Hulls and 10 sacks cement.

09-01-56

(If additional description is necessary, use BACK of this sheet)
Name of Plugging Contractor C-G Drilling Co.
Address 107 Rule Bldg., Wichita, Kansas

STATE OF KANSAS, COUNTY OF SEDGWICK, ss.
Jay H. Galloway (employee of owner) or (owner or operator) of the above-described well, being first duly sworn on oath, says: That I have knowledge of the facts, statements, and matters herein contained and the log of the above-described well as filed and that the same are true and correct. So help me God.

(Signature) Jay H. Galloway
Jay H. Galloway 107 Rule Bldg.
(Address)

SUBSCRIBED AND SWORN TO before me this 31st day of August, 1956

My commission expires March 22, 1960
Celeste B. Romine Notary Public.

PLUGGING
FILE SEC 4 T. 11 R. 19
BOOK PAGE 94 LINE 44

CONTRACTOR'S WELL LOG

OPERATOR C-G DRILLING CO. WELL NAME FORGUE #1
 LOCATION SE SE SE SECTION 4-11-19W RIG NO. 2
 COUNTY ELLIS STATE KANSAS
 COMMENCEMENT DATE AUGUST 20, 1956 COMPLETION DATE AUGUST 29, 1956

LOG OF WELL

Elevation 2077' rotary bushing
 All measurements taken from the top of rotary bushing.

FROM	TO	FORMATION	DEVIATION FROM VERTICAL	REMARKS
0	185	Sand-Shale		
185	515	Shale		
515	615	Sand-Shale		
615	695	Shale-Red Bed		
695	750	Shale-Sand		
750	800	Shale-Shells		
800	1280	Red Bed		
1280	1410	Anhydrite		
1410	1445	Shale		
1445	1575	Shale-Shells		
1575	1900	Shale-Shells		
1900	1950	Lime-Shale		
1950	2210	Lime-Shale		
2210	2490	Lime-Shale	0° - 2500	
2490	2625	Lime-Shale	0° - 2750	
2625	2785	Lime-Shale		
2785	2915	Lime-Shale	0° - 3000	
2915	3095	Lime-Shale		
3095	3234	Lime-Shale	0° - 3250	
3234	3300	Lime-Shale		
3300	3394	Lime-Shale	0° - 3500	
3394	3521	Lime-Shale		
3521	3605	Lime-Shale		
3605	3677	Cherty Conglomerate		DST 3378-91'

CASING LEFT IN HOLE AFTER COMPLETION:

Set 185.72' (9 jts.) 8-5/8" OD Surface Casing.

County of SEDGWICK, State of KANSAS) ss.

The undersigned hereby certifies that to the best of his knowledge and belief, the above facts are true and correct.

C-G DRILLING CO.

By Jay H. Galloway
 Jay H. Galloway

Subscribed and sworn to before me this 30th day of August, 1956.

My commission expires:
 March 22, 1960

Celeste B. Romine
 Celeste B. Romine, Notary Public

PLUGGING
 FILE SEC. 4 T. 11 R. 19W
 BOOK PAGE 94 OF 44