


15-135-20485-00-00

STATE OF KANSAS  
STATE CORPORATION COMMISSION

Form CP-4

WELL PLUGGING RECORD

Give All Information Completely  
Make Required Affidavit  
Mail or Deliver Report to:  
Conservation Division  
State Corporation Commission  
212 No. Market  
Wichita, Kansas 67202  
NORTH

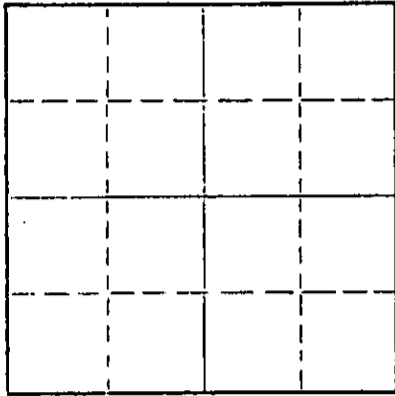

Locate well correctly on above  
Section Plat

Ness County. Sec. 7 Twp. 18S Rge. (E) 23 (W)

Location as "NE/CNW/SW" or footage from lines NE SW

Lease Owner Mull Drilling Co., Inc.

Lease Name Huenergardt Well No. "A" #1

Office Address 415 Page Court, 220 W. Douglas, Wichita, Ks.

Character of Well (completed as Oil, Gas or Dry Hole) Dry Hole

Date well completed 9-26 19 71

Application for plugging filed 9-26 19 71

Application for plugging approved 9-26 19 71

Plugging commenced 9-26 19 71

Plugging completed 9-26 19 71

Reason for abandonment of well or producing formation No oil or gas found in commercial quantities.

If a producing well is abandoned, date of last production ---- 19 --

Was permission obtained from the Conservation Division or its agents before plugging was commenced? Yes

Name of Conservation Agent who supervised plugging of this well Leo Massey

Producing formation \_\_\_\_\_ Depth to top \_\_\_\_\_ Bottom \_\_\_\_\_ Total Depth of Well 4420 Feet

Show depth and thickness of all water, oil and gas formations.

OIL, GAS OR WATER RECORDS

CASING RECORD

FORMATION	CONTENT	FROM	TO	SIZE	PUT IN	PULLED OUT
				8-5/8"	364'	-0-

Describe in detail the manner in which the well was plugged, indicating where the mud fluid was placed and the method or methods used in introducing it into the hole. If cement or other plugs were used, state the character of same and depth placed, from \_\_\_\_\_ feet to \_\_\_\_\_ feet for each plug set.

Set first plug at 600 feet with 50 sacks;

second plug at 330 feet with 25 sacks;

top plug at 40 feet with 10 sacks.

P.D. 9:00 p.m. 9-26-71.

RECEIVED  
STATE CORPORATION COMMISSION  
SEP 30 1971  
CONSERVATION DIVISION  
Wichita, Kansas

09-30-1971

Name of Plugging Contractor Rains & Williamson Oil Co., Inc.  
Address 435 Page Court, 220 W. Douglas, Wichita, Kansas

STATE OF KANSAS, COUNTY OF SEDGWICK, ss.

Wilson Rains


(employee of owner) or (owner or operator) of the above-described well, being first duly sworn on oath, says: That I have knowledge of the facts, statements, and matters herein contained and the log of the above-described well as filed and that the same are true and correct. So help me God.

(Signature) Wilson Rains Wilson Rains

435 Page Court, 220 W. Douglas, Wichita, Ks.

(Address)

Subscribed and sworn to before me this 28 day of September, 19 71

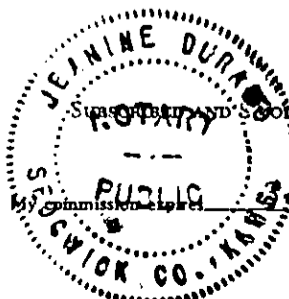

Jeanine Durand

Notary Public.

15-135-20485-00-00

ROTARY DRILLING LOG

Operator: Mull Drilling Co., Inc.  
HUENERGARDT "A" #1  
NE SW Section 7-18S-23W  
Ness County, Kansas

Contractor: Rains & Williamson  
Oil Co., Inc.

Commenced: 9-16-71  
Completed: 9-26-71

Casing: 8-5/8"/364'/180 sacks

Formations

Surface Clay and Shale	250'
Shale	1075'
Sand	1300'
Shale	1559'
Red Bed and Shale	1612'
Anhydrite	1650'
Shale and Lime	2425'
Shale	2615'
Shale and Lime	2830'
Lime and Shale	3635'
Lime	4357'
Lime and Chert	4420'
Rotary Total Depth	4420'

RECEIVED  
STATE CORPORATION COMMISSION  
SEP 30 1971  
CONSERVATION DIVISION  
Wichita, Kansas

09-30-1971

We certify the above log is true and correct, to the best of our knowledge and belief.

RAINS & WILLIAMSON OIL CO., INC.

*Wilson Rains*  
Wilson Rains

Subscribed and sworn to before me, a Notary Public within and for the State of Kansas, County of Sedgwick, this 28 day of September, 1971.

*Jeanine Durand*  
Jeanine Durand Notary Public

My Commission Expires: 3-31-74

