



CONFIDENTIAL

OIL & GAS CONSERVATION DIVISION

WELL COMPLETION FORM

WELL HISTORY - DESCRIPTION OF WELL & LEASE

OPERATOR: License # 34192

Name: SandRidge Exploration and Production LLC

Address 1: 123 ROBERT S. KERR AVE

Address 2: _____

City: OKLAHOMA CITY State: OK Zip: 73102 + 6406

Contact Person: Tiffany Golay

Phone: (405) 429-6543

CONTRACTOR: License # 34464

Name: Lariat Services, Inc.

Wellsite Geologist: Tammy Alcorn

Purchaser: Atlas (gas)/ Plains (oil)

Designate Type of Completion:

- New Well Re-Entry Workover
- Oil WSW SWD SIOW
- Gas D&A ENHR SIGW
- OG GSW Temp. Abd.
- CM (Coal Bed Methane)
- Cathodic Other (Core, Expl., etc.): _____

If Workover/Re-entry: Old Well Info as follows:

Operator: _____

Well Name: _____

Original Comp. Date: _____ Original Total Depth: _____

- Deepening Re-perf. Conv. to ENHR Conv. to SWD
- Conv. to GSW

Plug Back: _____ Plug Back Total Depth _____

Commingled Permit #: _____

Dual Completion Permit #: _____

SWD Permit #: _____

ENHR Permit #: _____

GSW Permit #: _____

3/8/2012 4/6/2012 4/9/2012

Spud Date or Date Reached TD Completion Date or
Recompletion Date Recompletion Date

API No. 15 - 15-077-21822-01-00

Spot Description: _____

N2 N2 NW NW Sec. 10 Twp. 35 S. R. 7 East West

250 Feet from North / South Line of Section

660 Feet from East / West Line of Section

Footages Calculated from Nearest Outside Section Corner:

- NE NW SE SW

County: Harper

Lease Name: Wesley Well #: 1-10H

Field Name: _____

Producing Formation: Mississippian

Elevation: Ground: 1300 Kelly Bushing: 1280

Total Depth: 9999 Plug Back Total Depth: _____

Amount of Surface Pipe Set and Cemented at: 850 Feet

Multiple Stage Cementing Collar Used? Yes No

If yes, show depth set: _____ Feet

If Alternate II completion, cement circulated from: _____

feet depth to: _____ w/ _____ sx cmt.

Drilling Fluid Management Plan

(Data must be collected from the Reserve Pit)

Chloride content: 50000 ppm Fluid volume: 700 bbls

Dewatering method used: Hauled to Disposal

Location of fluid disposal if hauled offsite:

Operator Name: Guard Disposal

Lease Name: unknown License #: 34268

Quarter NW Sec. 23 Twp. 22 S. R. 13 East West

County: Major, OK Permit #: 34268

AFFIDAVIT

I am the affiant and I hereby certify that all requirements of the statutes, rules and regulations promulgated to regulate the oil and gas industry have been fully complied with and the statements herein are complete and correct to the best of my knowledge.

Submitted Electronically

KCC Office Use ONLY

Letter of Confidentiality Received
Date: 07/03/2012

Confidential Release Date: _____

Wireline Log Received

Geologist Report Received

UIC Distribution

ALT I II III Approved by: NAOMI JAMES Date: 07/03/2012

	Measured Depth (ft)	Sub-Sea Incl. (ft)	Vertical Azim. (ft)	True Vert Depth (ft)	Northings (+) Southings (-) (ft)	Eastings (+) Westings (-) (ft)	DLS deg/100' (deg)	Sec10		Sec 15		FWL	FEL
								FNL	FSL	FNL	FSL		
SHL	0	0.00	0.00	0.00	0.00	0.00	0.00	250	8385	659	4820		
BHL	12453	93.42	176.75	4845.87	-7996.64	141.21	1.52	8247.27	387.54	685.84	4531.45		
Miss Entry	4974	59.00	180.20	4777.24	-535.07	4.82	12.43	784.75	7850.07	656.61	4618.58		
Top Perf	4980	61.32	178.84	4784.93	-549.09	4.85	13.58	798.77	7836.05	656.45	4618.83		
Bottom Perf	11560	88.71	178.12	4855.49	-7104.42	113.43	1.92	7354.86	1279.95	670.88	4553.33		

	Measured Depth (ft)	Sub-Sea Incl. (ft)	Vertical Azim. (ft)	True Vert Depth (ft)	Northings (+) Southings (-) (ft)	Eastings (+) Westings (-) (ft)	DLS deg/100' (deg)	Sec10		Sec 15		FWL	FEL
								FNL	FSL	FNL	FSL		
0	0.0	0	0	0	0	0	0	250	8385	659	4820		
890	0.80	66.80	889.97	2.45	5.71	0.09	247	8388	665	4814			
1384	0.20	121.40	1363.95	3.32	9.46	0.15	246	8388	669	4610			
1839	0.20	116.80	1838.95	2.51	10.91	0.00	247	8388	670	4609			
2314	0.50	208.10	2313.94	0.31	10.67	0.11	249	8385	670	4609			
2788	0.60	166.70	2787.92	-3.93	10.27	0.08	254	8381	670	4610			
3263	0.40	129.80	3262.91	-7.41	12.11	0.08	257	8378	671	4608			
3738	0.60	334.40	3737.90	-6.23	12.31	0.21	256	8379	672	4608			
3891	0.20	234.10	3890.90	-5.88	11.75	0.43	255	8379	671	4608			
3929	0.60	201.10	3928.89	-5.89	11.62	1.17	256	8379	671	4608			
3960	2.30	196.80	3959.88	-6.63	11.39	5.49	256	8378	671	4609			
3992	4.60	193.90	3991.82	-8.49	10.89	7.21	258	8377	670	4609			
4024	6.80	190.80	4023.66	-11.60	10.23	8.94	261	8374	670	4610			
4055	8.50	186.50	4054.39	-15.68	9.83	5.78	265	8369	669	4610			
4087	10.00	183.90	4085.97	-20.80	9.17	4.86	271	8364	668	4611			
4118	12.00	185.10	4117.38	-26.89	8.68	6.29	277	8358	668	4611			
4150	13.50	184.70	4147.81	-33.70	8.10	4.85	283	8351	667	4612			
4182	15.80	185.90	4178.57	-41.76	7.35	7.25	291	8343	666	4613			
4214	18.70	188.10	4209.13	-51.18	6.18	9.29	301	8334	665	4614			
4245	21.90	189.40	4238.20	-61.80	4.53	10.42	311	8323	663	4616			
4277	24.50	189.50	4267.61	-74.24	2.46	8.13	324	8311	661	4618			
4309	26.20	189.80	4296.53	-87.76	0.28	5.39	337	8297	659	4620			
4340	28.00	187.60	4324.12	-101.74	-1.72	6.07	351	8283	658	4622			
4372	29.60	183.70	4352.17	-117.07	-3.23	7.71	367	8268	655	4624			
4404	30.80	179.40	4379.83	-133.15	-3.65	7.73	383	8252	654	4624			
4435	31.80	177.50	4408.32	-149.25	-3.21	4.53	399	8236	654	4624			
4467	32.90	177.10	4433.35	-166.38	-2.41	3.50	416	8219	655	4623			
4498	35.30	176.80	4459.02	-183.71	-1.48	7.76	433	8201	655	4623			
4530	38.20	176.50	4484.65	-202.82	-0.36		452	8182	656	4622			
4560	41.30	177.80	4507.72	-221.98	0.69		472	8163	657	4621			
4593	42.80	178.40	4532.22	-244.07	1.32		494	8141	657	4620			
4625	45.80	178.30	4555.12	-266.41	1.76		516	8119	657	4620			
4657	48.10	180.20	4576.96	-289.79	1.86		539	8095	657	4620			
4688	49.70	180.40	4597.34	-313.15	1.74		563	8072	657	4620			
4720	49.80	180.00	4618.02	-337.57	1.65		587	8048	658	4620			
4752	49.90	180.10	4638.65	-362.03	1.63	0.39	612	8023	656	4621			
4784	50.10	179.70	4659.22	-386.55	1.87	1.14	636	7999	656	4621			
4816	49.80	178.80	4679.17	-410.27	1.98	2.42	660	7975	656	4621			
4847	48.50	178.50	4700.10	-434.47	2.55	4.12	684	7951	656	4620			
4879	49.10	178.40	4721.18	-458.54	3.21	1.89	708	7927	656	4620			
4910	52.00	178.20	4740.87	-482.46	3.92	9.37	732	7903	656	4619			
4942	55.20	178.80	4759.86	-508.21	4.59	10.11	758	7877	657	4619			
4974	59.00	180.20	4777.24	-535.07	4.82	12.43	785	7850	657	4619			
5005	63.50	179.50	4792.14	-562.24	4.89	14.65	812	7823	656	4619			
5037	66.80	179.50	4805.59	-591.27	5.14	10.31	841	7794	656	4619			
5069	69.70	179.20	4817.45	-620.99	5.48	9.10	871	7764	656	4618			
5100	72.50	179.60	4827.49	-650.31	5.79	9.11	900	7735	656	4618			
5132	75.30	179.70	4836.36	-681.06	5.98	8.76	931	7704	656	4618			
5164	77.80	179.90	4843.80	-712.17	6.08	7.84	962	7673	655	4618			
5195	81.10	180.60	4849.48	-742.65	5.95	10.87	992	7642	655	4619			
5235	86.40	181.80	4853.83	-782.38	5.12	13.58	1032	7603	653	4620			
5325	90.40	181.40	4856.34	-872.30	2.60	4.47	1122	7513	650	4623			
5357	90.40	181.90	4856.12	-904.28	1.88	1.56	1154	7481	648	4624			
5452	90.10	181.10	4855.71	-939.25	-0.80	0.90	1249	7386	644	4627			
5546	90.60	179.50	4855.13	-1093.24	-1.30	1.78	1343	7292	642	4628			
5841	90.30	179.00	4854.38	-1188.23	-0.05	0.61	1438	7197	642	4628			

5737	88.80	178.70	4855.14	-1284.20	1.87	1.59	1534	7101	643	4626
5831	89.50	178.70	4856.53	-1378.17	4.01	0.74	1628	7007	644	4625
5863	89.20	178.80	4856.90	-1410.18	4.70	0.99	1660	6976	644	4624
5927	90.80	179.10	4856.90	-1474.15	5.88	2.54	1724	6911	644	4624
6022	89.90	178.80	4856.32	-1569.13	7.62	1.00	1819	6816	645	4623
6117	90.90	180.10	4855.65	-1664.12	8.53	1.73	1914	6721	644	4622
6212	91.00	180.80	4854.08	-1759.10	7.78	0.74	2009	6626	642	4624
6307	91.00	179.90	4852.42	-1854.08	7.20	0.95	2104	6531	640	4625
6402	89.60	179.30	4851.92	-1949.08	7.87	1.60	2199	6436	639	4625
6497	89.30	179.10	4852.83	-2044.06	9.19	0.38	2294	6341	639	4624
6592	90.00	179.00	4853.42	-2139.05	10.77	0.74	2389	6246	640	4623
6687	90.10	178.40	4853.33	-2234.02	12.92	0.64	2484	6151	640	4622
6782	89.80	178.30	4853.42	-2328.98	15.88	0.33	2579	6056	642	4620
6876	86.40	178.10	4856.53	-2422.87	18.61	3.82	2673	5962	643	4617
6971	87.90	178.00	4861.25	-2517.70	21.84		2767	5867	645	4615
7066	88.60	178.30	4864.16	-2612.60	24.90	0.80	2862	5772	647	4612
7161	90.90	178.70	4864.57	-2707.56	27.39	2.46	2957	5677	648	4610
7256	90.70	179.10	4863.24	-2802.54	29.21	0.47	3052	5582	648	4609
7351	90.70	179.20	4862.87	-2897.52	29.67	0.32	3083	5551	648	4609
7376	90.80	179.30	4862.03	-2992.50	30.51	0.22	3147	5487	648	4608
7471	90.50	178.90	4861.74	-3022.51	30.90	2.00	3172	5402	648	4608
7566	90.00	178.70	4861.33	-3017.49	32.89	0.57	3267	5367	649	4607
7661	90.70	179.60	4860.75	-3112.48	34.30	1.20	3362	5272	649	4606
7756	90.80	179.70	4859.51	-3207.47	34.88	0.15	3457	5177	648	4606
7850	91.40	179.80	4857.68	-3302.45	35.30	0.64	3552	5082	647	4606
7945	90.70	179.20	4855.96	-3396.43	36.12	0.98	3646	4988	647	4606
8040	88.70	179.20	4856.46	-3491.41	37.44	2.11	3741	4893	647	4605
8136	87.90	178.40	4859.27	-3586.35	39.43	1.19	3836	4799	647	4604
8231	87.60	178.80	4863.04	-3682.25	41.78	0.52	3932	4703	648	4602
8231	89.40	179.80	4865.53	-3777.20	42.94	2.17	4027	4608	648	4602
8231	88.50	179.40	4865.53	-3777.20	42.94	#DIV/0!	4027	4608	648	4602
8326	90.50	180.20	4866.36	-3872.19	43.27	2.27	4122	4513	647	4602
8421	91.30	180.00	4864.67	-3967.18	43.10	0.87	4217	4418	646	4603
8516	89.50	180.50	4864.20	-4062.17	42.69	1.97	4312	4323	644	4604
8611	88.40	180.00	4865.95	-4157.15	42.27	1.27	4407	4228	642	4605
8706	89.30	179.50	4867.85	-4252.13	42.69	1.08	4502	4133	641	4605
8801	88.70	179.80	4869.51	-4347.12	43.27	0.71	4597	4038	640	4605
8896	89.70	177.80	4870.84	-4442.08	45.26	2.35	4692	3943	641	4604
8991	90.00	178.00	4871.08	-4537.01	48.74	0.38	4787	3848	643	4601
9085	92.20	179.00	4869.28	-4630.96	51.20	2.57	4881	3754	644	4599
9181	90.60	178.80	4866.93	-4726.91	53.21	1.72	4977	3658	645	4598
9276	89.80	178.90	4866.60	-4821.88	55.28	0.90	5072	3563	646	4596
9371	90.60	178.40	4866.27	-4916.85	57.52	0.99	5167	3468	646	4595
9466	92.40	180.20	4863.78	-5011.81	58.68	2.68	5262	3373	646	4594
9561	92.50	179.80	4859.72	-5106.72	58.88	0.43	5357	3278	645	4595
9656	88.80	178.80	4858.65	-5201.69	59.84	4.03	5452	3183	645	4594
9751	90.60	179.40	4859.14	-5296.67	61.33	2.00	5547	3088	645	4593
9846	91.60	180.10	4857.32	-5391.65	61.75	1.28	5642	2993	644	4594
9941	91.40	180.20	4854.83	-5486.62	61.50	0.24	5737	2898	642	4595
10036	91.10	179.30	4852.76	-5581.59	61.91	1.00	5832	2803	641	4595
10131	90.70	178.80	4851.27	-5676.57	63.49	0.67	5927	2708	641	4594
10277	89.30	178.90	4851.27	-5822.53	66.42	0.96	6073	2562	642	4592
10322	88.80	179.20	4852.01	-5867.52	67.16	1.30	6118	2517	642	4591
10414	89.50	178.20	4853.38	-5959.49	69.25	1.33	6210	2425	643	4590
10509	89.60	178.10	4854.13	-6054.43	72.32	0.15	6305	2330	645	4588
10604	90.10	178.10	4854.37	-6149.38	75.47	0.53	6400	2235	647	4585
10699	91.30	177.80	4853.21	-6244.31	78.86	1.30	6495	2140	649	4582
10794	90.60	177.80	4851.64	-6339.23	82.51	0.74	6589	2045	651	4579
10889	91.50	177.80	4849.90	-6434.14	86.16	0.95	6684	1950	653	4576
10984	90.20	178.00	4848.49	-6529.06	89.64	1.38	6779	1855	655	4573
11079	89.70	177.90	4848.57	-6624.00	93.04	0.54	6874	1761	657	4571
11174	90.20	177.50	4848.65	-6718.93	96.85	0.67	6969	1666	660	4567
11269	90.70	177.20	4847.91	-6813.82	101.24	0.61	7064	1571	663	4564
11364	88.80	177.90	4848.32	-6908.73	105.30	2.13	7159	1476	666	4560
11459	87.00	177.20	4851.80	-7003.67	109.36	2.03	7264	1381	668	4557
11554	88.70	178.10	4855.37	-7098.62	113.25	2.02	7369	1286	671	4553

Section 4
35S 7W

Section 3
35S 7W

WESLEY 1-10H




Miss Entry: 4974'
-98.071223 37.01985
Top Perf: 4990'
-98.071224 37.019779

Section 9
35S 7W

Section 10
35S 7W

Section 16
35S 7W

Section 15
35S 7W
Bottom Perf: 11224'
-98.070992 37.002609

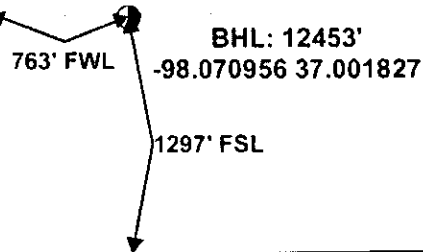

BHL: 12453'
-98.070956 37.001827

Section 17
29N 8W

Section 16
29N 8W



Actual Bottom-Hole Location of Wesley 1-10H
Harper County, Kansas

T&R: 35S 7W
Section: 15, 763' FWL & 1297' FSL
Long/Lat: -98.070956 37.001827

1 in = 1,042 ft




● Actual BH Location

* SandRidge Wells

Perf

□ Sections

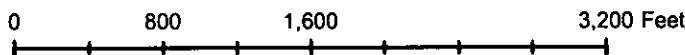

Draftsman:

Aaron Birk

Draft Date: 6/26/2012

Drawing Name/Number:

Addendum_Wesley_1-10H.mxd

Coordinate System:

NAD 1927 State Plane
Kansas South FIPS: 1502