

15-135-21336-00-00

FORM CP-4


STATE OF KANSAS  
STATE CORPORATION COMMISSION

WELL PLUGGING RECORD

Give All Information Completely  
Make Required Affidavit  
Mail or Deliver Report to  
Conservation Division  
State Corporation Comm.  
245 North Water  
Wichita, KS 67202

Ness County, Sec. 13 Twp. 19S Rge 25W E/W  
Location as "NE/CNW $\frac{1}{4}$ /SW $\frac{1}{4}$ " or footage from lines  
C NE NE

Lease Owner John Jay Darrah, Jr.  
Lease Name Bondurant Well No. #1  
Office Address Suite 1010, Century Plaza Bldg., Wichita, Ks.  
Character of Well (Completed as Oil, Gas or Dry Hole)

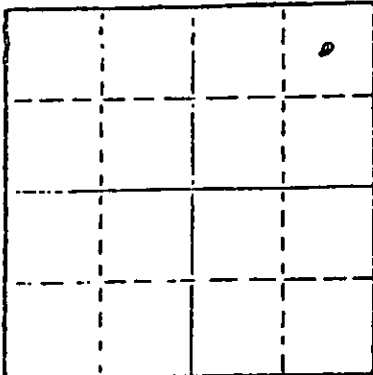

Locate well correctly on above  
Section Plot

D & A  
Date Well completed June 6 1977  
Application for plugging filed June 6 1977  
Application for plugging approved June 6 1977  
Plugging commenced June 6 1977  
Plugging completed June 6 1977

Reason for abandonment of well or producing formation  
dry hole

If a producing well is abandoned, date of last production  
19

Was permission obtained from the Conservation Division or  
its agents before plugging was commenced? yes

Name of Conservation Agent who supervised plugging of this well Leo Massey  
Producing formation Depth to top Bottom Total Depth of Well  
Show depth and thickness of all water, oil and gas formations.

OIL, GAS OR WATER RECORDS

CASING RECORD

FORMATION	CONTENT	FROM	TO	SIZE	PUT IN	PULLED OUT
		0	290	8-5/8"		

Describe in detail the manner in which the well was plugged, indicating where the mud fluid  
was placed and the method or methods used in introducing it into the hold. If cement or other  
plugs were used, state the character of same and depth placed, from feet to  
feet for each plug set. Hole plugged as follows: plugged @ 720' with 70 sacks  
50-50 pozmix, plugged @ 240' with 20 sacks 50-50 pozmix, plugged @ 40' with 10 sacks  
50-50 pozmix; plug down 5:30 a.m., June 6, 1977.

JUN 15 1977  
00-151977

(If additional description is necessary, use BACK of this sheet)

Name of Plugging Contractor Strata Drilling Company

STATE OF KANSAS COUNTY OF BARTON, ss.


Kenneth J. Link (XXXXXXXXXXXX) or (owner or operator  
of the above-described well, being first duly sworn on oath, says: That I have knowledge of  
the facts, statements, and matters herein contained and the log of the above-described well  
as filed and that the same are true and correct. So help me God.

(Signature) Kenneth J. Link President  
Box 355, Great Bend, Kansas 67530  
(Address)

SUBSCRIBED AND SWORN TO before me this 9th day of June, 1977

Loneita Barry  
Loneita Barry Notary Public.

My commission expires 3-28-80

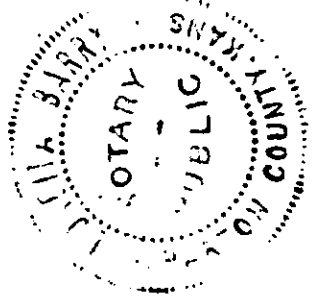

15-135-21336-00-00

D R I L L E R S   L O G

#1 Bondurant

CASING RECORD: 293.46' used 8-5/8" surface casing	COMPANY: John Jay Darrah, Jr.	DESCRIPTION: C NE NE Section 13-19S-25W Ness County, Kansas
TOTAL DEPTH: 4400'	CONTRACTOR: Strata Drilling Company	ELEVATION: 2331' GL
	COMMENCED: May 31, 1977	
	COMPLETED: June 6, 1977	

D & A

<u>FORMATION</u>	<u>FROM</u>	<u>TO</u>	<u>REMARKS</u>
Shale, shells and rocks	0	310	Ran 293.46' used 8-5/8" surface casing; set and cemented at 299' with 200 sacks common cement, 2% gel, 3% C.C.; cement circulated. Plug down @ 9:30 p.m., May 31, 1977.
Shale and sand	310	1420	
Shale	1420	1610	
Anhydrite	1610	1650	
Shale	1650	2300	
Lime and shale	2300	4400	

Ran one electric log.

Hole plugged as follows: plugged @ 720' with 70 sacks 50-50 pozmix, plugged @ 240' with 20 sacks 50-50 pozmix, plugged @ 40' with 10 sacks 50-50 pozmix; plug down 5:30 a.m., June 6, 1977.

STATE OF KANSAS )  
 ) ss  
 COUNTY OF BARTON )  
 JUN 15 1977  
 06-15-1977

STATE OF KANSAS )  
 ) ss  
COUNTY OF BARTON)

I certify that this is a true and correct copy of the above log to the best of my knowledge.

STRATA DRILLING COMPANY

*Kenneth J. Link*  
 \_\_\_\_\_  
 Kenneth J. Link, President

Subscribed and sworn to before me this 9th day of June, 1977.

My commission expires: 3-28-80.

*Loneita Barry*  
 \_\_\_\_\_  
 Loneita Barry, Notary Public

