

WELL PLUGGING RECORD

Give All Information Completely
Make Required Affidavit
Mail or Deliver Report to:
Conservation Division
State Corporation Commission
211 No. Broadway
Wichita, Kansas

Ness County. Sec. 8 Twp. 19S Rge. (E) 25 (W)

Location as "NE/CNW/SW" or footage from lines SE-NE-SW

Lease Owner Kewanee Oil Company

Lease Name Beardslee Well No. 1

Office Address Box 360, Hoisington, Kansas

Character of Well (completed as Oil, Gas or Dry Hole) Dry hole

Date well completed 12-24-1958

Application for plugging filed 12-24-1958

Application for plugging approved Verbal 12-23-1958


Plugging commenced 12-24-1958

Plugging completed 12-24-1958

Reason for abandonment of well or producing formation Dry Hole

If a producing well is abandoned, date of last production 19

Was permission obtained from the Conservation Division or its agents before plugging was commenced? Mr. M. A. Rives - Verbal on 12-23-58

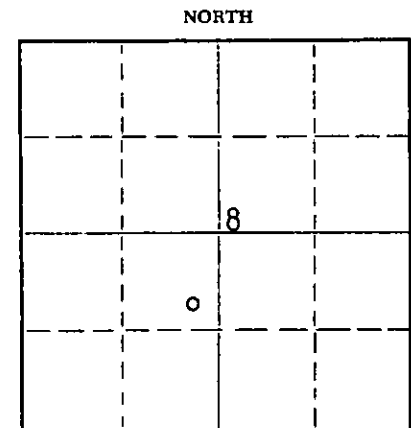

Locate well correctly on above Section Plat

Name of Conservation Agent who supervised plugging of this well Mr. M. A. Rives

Producing formation Mississippi Depth to top 4571 Bottom 4695 Total Depth of Well 4695 Feet

Show depth and thickness of all water, oil and gas formations.

OIL, GAS OR WATER RECORDS

CASING RECORD

FORMATION	CONTENT	FROM	TO	SIZE	PUT IN	PULLED OUT
Heebner	Dry	3924		8-5/8"	537'	None
Toronto	"	3942				
Lansing	"	3966				
Warmaton	"	4346				
Mississippi	"	4571	4695			

Describe in detail the manner in which the well was plugged, indicating where the mud fluid was placed and the method or methods used in introducing it into the hole. If cement or other plugs were used, state the character of same and depth placed, from _____ feet to _____ feet for each plug set.

Filled with mud from 4695' to 525'.
Halliburton plug at 525'.
20 sacks cement 525' to 465'.
Filled with mud from 465' to 35'.
Halliburton plug at 35'.
Filled with cement to base of cellar.
Plugging completed at 2:00 A.M. 12-24-58.

(If additional description is necessary, use BACK of this sheet)

Name of Plugging Contractor Graham-Michaelis Drilling Company

Address Wichita, Kansas

STATE OF Kansas COUNTY OF Barton, ss.

Peter Blanda (employed of owner) or (owner or operator) of the above-described well, being first duly sworn on oath, says: That I have knowledge of the facts, statements, and matters herein contained and the log of the above-described well as filed and that the same are true and correct. So help me God.

(Signature) Peter Blanda

Box 360, Hoisington, Kansas

SUBSCRIBED AND SWORN TO before me this 29th day of December, 1958

My commission expires September 21, 1961

[Notary Signature]
Notary Public.

01-03-1959

PLUGGING
FILE SEC 8 T. 19 R. 25W
BOOK PAGE 9 LINE 6

15-135-00046-00-00

KEWANEE OIL COMPANY

WELL RECORD: Beardslee Well No. 1 Elevation: 2582' Cement Marker
(C.M. 3.00' above top of 8-5/8" Casing Cellar).

Located: 2310' from the West line and 1650' from the South line of the SW/4 of Section 8, T-19-S, R-25-W, Ness County, Kansas.

Contractors: Graham-Michaelis Drilling Company.

Drilling Commenced: December 9, 1958.

Drilling Completed: December 22, 1958.

Completion Date: December 24, 1958.

Total Depth: 4695' Cement Marker.

Initial Production: None. Plugged and Abandoned.

Treating Record: None.

Perforating Record: None.

Sample Tops - C. M. Measurement

Hoebner	3926	(-1344)
Toronto	3943	(-1361)
Lansing-Kansas City	3966	(-1384)
Base Kansas City	4318	(-1736)
Narvaton	4344	(-1762)
Cherokee	4470	(-1888)
Conglomerate	4557	(-1975)
Mississippi	4574	(-1992)
Total Depth (Driller)	4694	(-2112)

Schlumberger Log Tops - C. M. Measurement

Hoebner	3924	(-1342)
Toronto	3942	(-1360)
Lansing-Kansas City	3966	(-1384)
Base Kansas City	4318	(-1736)
Narvaton	4346	(-1764)
Cherokee	4471	(-1889)
Conglomerate	4557	(-1975)
Mississippi	4571	(-1989)
Total Depth (Log)	4695	(-2113)

Casing Record

8-5/8" O.D. Casing (17 joints) set at 537.08' C.M. and cemented with 350 sacks pozzix with 1/2" floccs per sack and 2% Calcium Chloride. Cement Circulated.

Formation Record

0	Surface
540	Clay, shale
1225	Shale, strk of sand & red bed
1250	Shale, sand
1270	Anhydrite
1345	Sand, shale
2065	Shale, lime
3435	Lime, shale
3856	Shale, lime
4000	Lime, shale
4694	Lime, dolomite - Total Depth

RECEIVED
STATE OF KANSAS
12-30-1958
DEC 30 1958
CONSERVATION DIVISION
WELL REGISTRATION

PLUGGING
FILE SEC 8 T.19 R.25W
BOOK PAGE 9 LINE 6

15-135-00046-00-00

Kewanee Oil Company

WELL RECORD: Beardslaw Well No. 1 (Continued)

Slope Tests

<u>Depth</u>	<u>Deviation</u>
100	1/2°
200	1/4°
300	1/2°
540	1/2°
1000	3/4°
1500	1°
2000	3/4°
2520	3/4°
2802	1/4°
3140	0°
3460	1°
3790	1°
4225	1°

Record by: Peter Klanda and R. J. Davis

RECEIVED
STATE OF KANSAS

DEC 30 1955

CONSERVATION
Wichita, Kansas