

15-135-20285-00-00


STATE OF KANSAS
STATE CORPORATION COMMISSION

Form CP-4

WELL PLUGGING RECORD

Give All Information Completely
Make Required Affidavit
Mail or Deliver Report to:
Conservation Division
State Corporation Commission
212 No. Market
Wichita, Kansas 67202

NORTH

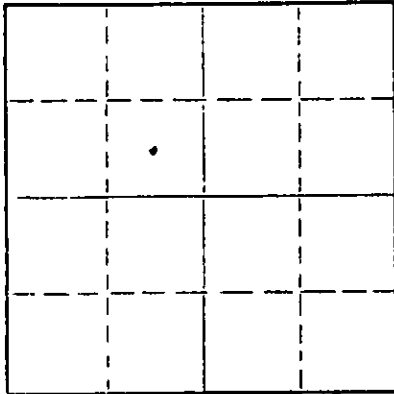

Locate well correctly on above
Section Plat

Ness County, Sec. 36 Twp. 19 Rge. (E) 25 (W)
Location as "NE/CNW/SW" or footage from lines C SE NW
Lease Owner Beardmore Oil, Inc.
Lease Name Schlegel "C"
Office Address 700 One Twenty Building, Wichita, Kansas 67202
Well No. 1
Character of Well (completed as Oil, Gas or Dry Hole) oil
Date well completed _____ 19____
Application for plugging filed September 15 19 70
Application for plugging approved _____ 19____
Plugging commenced October 3 19 70
Plugging completed October 19 19 70
Reason for abandonment of well or producing formation depleted

If a producing well is abandoned, date of last production _____ 19____
Was permission obtained from the Conservation Division or its agents before plugging was commenced? yes

Name of Conservation Agent who supervised plugging of this well Leo Massey
Producing formation _____ Depth to top _____ Bottom _____ Total Depth of Well 4417 Feet
Show depth and thickness of all water, oil and gas formations.

OIL, GAS OR WATER RECORDS

CASING RECORD

FORMATION	CONTENT	FROM	TO	SIZE	PUT IN	PULLED OUT
		0	546'	8 5/8"	546'	none
		0	4406'	5 1/2"	4406'	1852.05 1045.04 plastic wrap

Describe in detail the manner in which the well was plugged, indicating where the mud fluid was placed and the method or methods used in introducing it into the hole. If cement or other plugs were used, state the character of same and depth placed, from _____ feet to _____ feet for each plug set.

Sanded back to 4390' and dumped 5 sacks of cement.
Set 20' rock bridge at 520'. Plug well with 4 1/2 yards of ready mix cement.

RECEIVED
STATE CORPORATION COMMISSION
OCT 28 1970
CONSERVATION DIVISION
Wichita, Kansas
10-28-1970

(If additional description is necessary, use BACK of this sheet)
Name of Plugging Contractor PIPE PULLERS, INC.
Address Box 486, Ellinwood, Kansas

STATE OF KANSAS, COUNTY OF BARTON, ss.
Evelyn Roth (employee of owner) or (owner or operator) of the above-described well, being first duly sworn on oath, says: That I have knowledge of the facts, statements, and matters herein contained and the log of the above-described well as filed and that the same are true and correct. So help me God.

(Signature) Evelyn Roth
Ellinwood, Kansas
(Address)

SUBSCRIBED AND SWORN TO before me this 26th day of October, 19 70

My commission expires Feb. 10, 1971
George A. Meyer Notary Public.

15-135-20285-00-00

ROTARY DRILLING LOG

Operator: Beardmore Oil Inc.
SCHLEGEL "C" #1
SE NW Section 36-19S-25W
Ness County, Kansas

Contractor: Rains & Williamson
Oil Co., Inc.
Commenced: 9-17-69
Completed: 9-29-69

Casing: 8-5/8"/546'/275 sx.
5-1/2"/4406'/175 sx.

Formations

Sand and Shale	365'
Shale	1011'
Blaine Anhydrite	1026'
Shale	1110'
Sand	1355'
Shale	1625'
Anhydrite	1667'
Shale	2235'
Shale and Lime	2345'
Lime	2670'
Lime and Shale	2773'
Lime	2895'
Lime and Shale	3180'
Shale and Lime	3673'
Lime	4407'
Core (Lime)	4417'
Rotary Total Depth	4417'

We certify the above log is true and correct, to the best of our knowledge and belief.

RAINS & WILLIAMSON OIL CO., INC.



Wilson Rains

Subscribed and sworn to before me, a Notary Public within and for the State of Kansas, County of Sedgwick, this 3rd day of October, 1969.

Sherry Gish

Notary Public

RECEIVED
STATE CORPORATION COMMISSION
SEP 16 1970
CONSERVATION DIVISION
Wichita, Kansas
09-16-1970

My Commission Expires:
6-30-71