

CARD MUST BE TYPED

State of Kansas

CARD MUST BE SIGNED

NOTICE OF INTENTION TO DRILL

(see rules on reverse side)

Starting Date 9 9 86 month day year 10:53

API Number 15- 135-23,055-00-00

OPERATOR: License # 4291
Name Trans. Resource Dev. Corp.
Address Box 14983
City/State/Zip Lenexa, Kansas 66215
Contact Person Tim Warkins
Phone 913-541-1862

NE NE NE... Sec. 12 Twp. 18 S, Rg. 23... East West
4950 Ft. from South Line of Section
330 Ft. from East Line of Section

(Note: Locate well on Section Plat on reverse side)

CONTRACTOR: License # 5671
Name Revlin Drilling, Inc.
City/State Box 293, Russell, Kansas 67665

Nearest lease or unit boundary line 330 feet
County Ness
Lease Name Ed Langer Well # 1

Well Drilled For: Well Class: Type Equipment:
X Oil SWD X Infield X Mud Rotary
Gas Inj Pool Ext Air Rotary
OWWO Expl Wildcat Cable

Ground surface elevation n/a feet MSL
Domestic well within 330 feet: yes X no
Municipal well within one mile: yes X no

If OWWO: old well info as follows:

Operator
Well Name
Comp Date Old Total Depth

Depth to bottom of fresh water 50
Depth to bottom of usable water 479
Surface pipe by Alternate: 1 X 2
Surface pipe planned to be set 500
Conductor pipe required
Projected Total Depth 4350 feet
Formation Mississippian

I certify that well will comply with K.S.A. 55-101, et seq., plus eventually plugging hole to KCC specifications.

Date 9/9/86 Signature of Operator or Agent C. Vona as agent

For KCC Use:

Conductor Pipe Required 500 feet; Minimum Surface Pipe Required 24 feet per Alt.
This Authorization Expires 3-9-87 Approved By 8-9-86


Handwritten signature: RCH/KCC

Must be filed with the K.C.C. five (5) days prior to commencing well
This card void if drilling not started within six (6) months of date received by K.C.C.

Important procedures to follow:

1. Notify District office before setting surface casing.
2. Set surface casing by circulating cement to the top.
3. File completion forms ACO-1 with K.C.C. within 90 days of well completion, following instructions on ACO-1, side 1, and including copies of wireline logs.
4. Notify District office 48 hours prior to old well workover or re-entry.
5. Prior to filing Intent, prepare a proposed plugging plan in case well is D & A, then obtain approval of plan when calling district office prior to setting surface pipe.
6. Submit plugging report (CP-4) to K.C.C. after plugging is completed.
7. Obtain an approved injection docket number before disposing of salt water.
8. Notify K.C.C. within 10 days when injection commences or terminates.

A Regular Section of Land
1 Mile = 5,280 Ft.

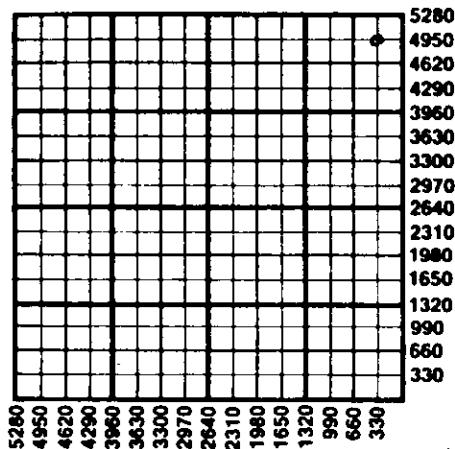

RECEIVED
STATE CORPORATION COMMISSION

SEP 9 - 1986
09-09-1986
CONSERVATION DIVISION
Wichita, Kansas

If an alternate 2 completion, cement in the production pipe from below any usable water to surface within 120 days of spud date.

State Corporation Commission of Kansas
Conservation Division
200 Colorado Derby Building
Wichita, Kansas 67202
(316) 263-3238