CARD MUST BE TYPED

State of Kansas
NOTICE OF INTENTION TO DRILL
(see rules on reverse side)

CORRECTED
~~CARD MUST BE SIGNED~~
1-23-85

Starting Date: 1 (month) 29 (day) 85 (year)

API Number 15- 135-22,763-00-00

OPERATOR: License # 6177
Name Foxfire Exploration, Inc.
Address P. O. Box 6360
City/State/Zip Los Osos, California 93402
Contact Person D. C. Marchant
Phone (805) 528-6008

CONTRACTOR: License # 8430
Name Foxfire Drilling Company
City/State WaKeeney, Kansas 67672

Well Drilled For: [X] Oil [ ] Gas [ ] OWWO [ ] Swd [ ] Inj [ ] Expl
Well Class: [ ] Infield [ ] Pool Ext. [X] Wildcat
Type Equipment: [X] Mud Rotary [ ] Air Rotary [ ] Cable

If OWWO: old well info as follows:
Operator
Well Name
Comp Date ..... Old Total Depth .....
Projected Total Depth 4400' feet
Projected Formation at TD Mississippian
Expected Producing Formations Mississippian

[ ] East [X] West
C SE NW Sec. 16 Twp. 18 S, Rge. 23.
(location)
3300 Ft North from Southeast Corner of Section
3300 Ft West from Southeast Corner of Section
(Note: Locate well on Section Plat on reverse side)

Nearest lease or unit boundary line 990 feet.
County Ness
Lease Name Beardslee "B" Well# 1
Domestic well within 330 feet: [ ] yes [X] no
Municipal well within one mile: [ ] yes [X] no

Depth to Bottom of fresh water 60 feet
Lowest usable water formation Dakota
Depth to Bottom of usable water 650 feet
Surface pipe by Alternate: 1 [ ] 2 [X]
Surface pipe to be set 320' feet
Conductor pipe if any required N/A feet
Ground surface elevation Est. 2303 feet MSL
This Authorization Expires 7/14/85
Approved By 1/14/85

I certify that we will comply with K.S.A. 55-101, et seq., plus eventually plugging hole to K.C.C. specifications.

Date 1/17/85 Signature of Operator or Agent D. C. Marchant Title Owner

NESW C W/2 SE NW 3630 FWL

Form C-1 4/84

Must be filed with the K.C.C. five (5) days prior to commencing well
This card void if drilling not started within six (6) months of date received by K.C.C.

A Regular Section of Land
1 Mile = 5,280 Ft.

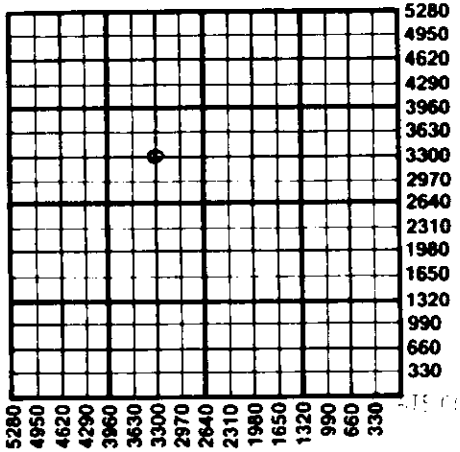

Important procedures to follow:

1. Notify District office before setting surface casing.
2. Set surface casing by circulating cement to the top.
3. File completion forms ACO-1 with K.C.C. within 90 days of well completion, following instructions on ACO-1, side 1, and including copies of wireline logs.
4. Notify District office 48 hours prior to old well workover or re-entry.
5. Prior to plugging, prepare a plugging plan, then obtain agreement from the appropriate district office for an approved plugging plan.
6. Submit plugging report (CP-4) to K.C.C. after plugging is completed.
7. Obtain an approved injection docket number before disposing of salt water.
8. Notify K.C.C. within 10 days when injection commences or terminates.
9. If an alternate 2 completion, cement in the production pipe from below any usable water to surface within 120 days of spud date.

RECEIVED
STATE CORPORATION COMMISSION

JAN 2 2 1985

01-22-1985

CONSERVATION DIVISION
Wichita, Kansas

State Corporation Commission of Kansas
Conservation Division
200 Colorado Derby Building
Wichita, Kansas 67202
(316) 263-3238