

CARD MUST BE TYPED

State of Kansas  
**NOTICE OF INTENTION TO DRILL**

CARD MUST BE SIGNED

(see rules on reverse side)

Starting Date: January 10, 1984  
month day year

API Number 15- 135-22,750-00-00

OPERATOR: License # 6177

East  
..C.. SW. NE. Sec 16. Twp 18. S. Rge 23.  West  
(location)

Name Foxfire Exploration, Inc.

Address P. O. Box 6360

City/State/Zip Los Osos, California 93402

Contact Person D. C. Marchant

Phone (805) 528-6008

3300 Ft North from Southeast Corner of Section  
1980 Ft West from Southeast Corner of Section  
(Note: Locate well on Section Plat on reverse side)

CONTRACTOR: License # 8430

Name Foxfire Drilling Co., P. O. Box 133

City/State WaKeeney, Kansas 67672

Nearest lease or unit boundary line 660 feet.  
County Ness  
Lease Name Beardslee "A" Well # 1

Well Drilled For: Well Class: Type Equipment:

Oil  Swd  Infield  Mud Rotary  
 Gas  Inj  Pool Ext.  Air Rotary  
 OWWO  Expl  Wildcat  Cable

Domestic well within 330 feet:  yes  no  
Municipal well within one mile:  yes  no

If OWWO: old well info as follows:

Operator N/A  
Well Name .....  
Comp Date ..... Old Total Depth .....  
Projected Total Depth 4350 feet  
Projected Formation at TD Mississippian  
Expected Producing Formations Cherokee Sand

Depth to Bottom of fresh water 75' feet  
Lowest usable water formation Dakota  
Depth to Bottom of usable water 650' feet  
Surface pipe by Alternate: 1  2   
Surface pipe to be set 320 feet  
Conductor pipe if any required None feet  
Ground surface elevation 2302 feet MSI  
This Authorization Expires 6-14-85  
Approved By 12-14-84 *R*

I certify that we will comply with K.S.A. 55-101, et seq., plus eventually plugging hole to K.C.C. specifications.

Date 12/4/84 Signature of Operator or Agent *D. Marchant*


Title ..... Owner

*MHC/WOHE 12/14/84*  
Form C-1 4/84

Must be filed with the K.C.C. five (5) days prior to commencing well  
This card void if drilling not started within six (6) months of date received by K.C.C.

**Important procedures to follow :**

**A Regular Section of Land**  
**1 Mile = 5,280 Ft.**

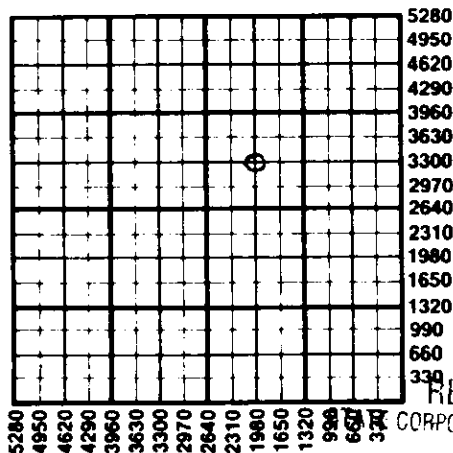

1. Notify District office before setting surface casing.
2. Set surface casing by circulating cement to the top.
3. File completion forms ACO-1 with K.C.C. within 90 days of well completion, following instructions on ACO-1, side 1, and including copies of wireline logs.
4. Notify District office 48 hours prior to old well workover or re-entry.
5. Prior to plugging, prepare a plugging plan, then obtain agreement from the appropriate district office for an approved plugging plan.
6. Submit plugging report (CP-4) to K.C.C. after plugging is completed.
7. Obtain an approved injection docket number before disposing of salt water.
8. Notify K.C.C. within 10 days when injection commences or terminates.
9. If an alternate 2 completion, cement in the production pipe from below any usable water to surface within 120 days of spud date.

RECEIVED  
CORPORATION COMMISSION

**State Corporation Commission of Kansas**  
**Conservation Division**  
**200 Colorado Derby Building**  
**Wichita, Kansas 67202**  
**(316) 263-3238**

DEC 14 1984  
12-14-1984  
CONSERVATION DIVISION  
Wichita, Kansas