

CARD MUST BE TYPED

State of Kansas
NOTICE OF INTENTION TO DRILL

(see rules on reverse side)

CARD MUST BE SIGNED

Starting Date: 11 17 84
 month day year

OPERATOR: License # 5190
 Name Sabre Exploration, Inc.
 Address 310 W. Central, #214
 City/State/Zip Wichita, KS 67202
 Contact Person Matt Totten
 Phone 316 264-2635

CONTRACTOR: License # 9943
 Name Republic Drilling
 City/State Pratt, KS

Well Drilled For:	Well Class:	Type Equipment:
☒ Oil ☐ Swd ☐ Infield ☒ Mud Rotary		
☐ Gas ☐ Inj ☐ Pool Ext. ☐ Air Rotary		
☐ OWWO ☐ Expl ☒ Wildcat ☐ Cable		

If OWWO: old well info as follows:

Operator
 Well Name
 Comp Date Old Total Depth
 Projected Total Depth 4600 feet
 Projected Formation at TD Mississippian
 Expected Producing Formations Mississippian

I certify that we will comply with K.S.A. 55-101, et seq., plus eventually plugging hole to K.C.C. specifications.

Date 11/13/84 Signature of Operator or Agent *Matt Totten* Title President.....

API Number 15- 135-22,727-0000
 SE NE SW 15 18 26 ☐ East
 (location) Sec Twp S. Rge ☒ West

1650 Ft North from Southeast Corner of Section
 2970 Ft West from Southeast Corner of Section
 (Note: Locate well on Section Plat on reverse side)

Nearest lease or unit boundary line feet.
 County Ness
 Lease Name Walter Well # 1
 Domestic well within 330 feet: ☐ yes ☒ no
 Municipal well within one mile: ☐ yes ☒ no

Depth to Bottom of fresh water 100' feet
 Lowest usable water formation Dakota
 Depth to Bottom of usable water 800 feet
 Surface pipe by Alternate: 1 ☐ 2 ☒
 Surface pipe to be set 350 feet
 Conductor pipe if any required 0 feet
 Ground surface elevation 2627 feet MSL.
 This Authorization Expires 5/13/85
 Approved By 11-13-84 *[Signature]*

MHC/KDHE 11/13/84


Wichita, Kansas

Must be filed with the K.C.C. five (5) days prior to commencing well
This card void if drilling not started within six (6) months of date received by K.C.C.

NOV 4 3 1984

NOV 11 1984

A Regular Section of Land
1 Mile = 5,280 Ft.

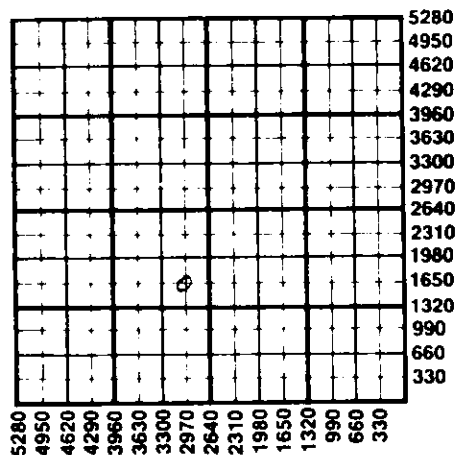

Important procedures to follow :

1. Notify District office before setting surface casing.
2. Set surface casing by circulating cement to the top.
3. File completion forms ACO-1 with K.C.C. within 90 days of well completion, following instructions on ACO-1, side 1, and including copies of wireline logs.
4. Notify District office 48 hours prior to old well workover or re-entry.
5. Prior to plugging, prepare a plugging plan, then obtain agreement from the appropriate district office for an approved plugging plan.
6. Submit plugging report (CP-4) to K.C.C. after plugging is completed.
7. Obtain an approved injection docket number before disposing of salt water.
8. Notify K.C.C. within 10 days when injection commences or terminates.
9. If an alternate 2 completion, cement in the production pipe from below any usable water to surface within 120 days of spud date.

State Corporation Commission of Kansas
Conservation Division
200 Colorado Derby Building
Wichita, Kansas 67202
(316) 263-3238