

CARD MUST BE TYPED

State of Kansas

CARD MUST BE SIGNED

NOTICE OF INTENTION TO DRILL

(see rules on reverse side)

Starting Date 12 11 86
month day year 1986

API Number 15- 135-23,083-0000

OPERATOR: License # 5363

NW NE NE Sec. 5 Twp. 19 S, Rg. 24 West

Name BEREXCO INC.

Address 970 Fourth Financial Center

City/State/Zip Wichita, Kansas 67202

Contact Person Evan Mayhew

Phone (316) 265-3311

4950 Ft. from South Line of Section

990 Ft. from East Line of Section

(Note: Locate well on Section Plat on reverse side)

Nearest lease or unit boundary line 330 feet

County Ness

Lease Name Harkness Well # 1

Ground surface elevation 2348 feet MSL

Domestic well within 330 feet: ___yes no

Municipal well within one mile: ___yes no

Depth to bottom of fresh water 100

Depth to bottom of usable water 950 550

Surface pipe by Alternate: ~~2~~ 2

Surface pipe planned to be set 250

Conductor pipe required

Projected Total Depth 4450 feet

Formation Mississippian

CONTRACTOR: License # 5147

Name BEREDCO INC.

City/State Wichita, Kansas

Well Drilled For: Well Class: Type Equipment:

Oil ___ SWD ___ Infield Mud Rotary

___ Gas ___ Inj Pool Ext. ___ Air Rotary

___ OWWO ___ Expl ___ Wildcat ___ Cable

If OWWO: old well info as follows:

Operator

Well Name

Comp Date Old Total Depth

I certify that well will comply with K.S.A. 55-101, et seq., plus eventually plugging hole to KCC specifications.

Date 12-9-86 Signature of Operator or Agent Title

For KCC Use:

Conductor Pipe Required feet; Minimum Surface Pipe Required 250 feet per Alt. 9 (2)

This Authorization Expires 6-10-87 Approved By 12-10-86


Red/ken

Must be filed with the K.C.C. five (5) days prior to commencing well
This card void if drilling not started within six (6) months of date received by K.C.C.

Important procedures to follow:

1. Notify District office before setting surface casing.
2. Set surface casing by circulating cement to the top.
3. File completion forms ACO-1 with K.C.C. within 90 days of well completion, following instructions on ACO-1, side 1, and including copies of wireline logs.
4. Notify District office 48 hours prior to old well workover or re-entry.
5. Prior to filing Intent, prepare a proposed plugging plan in case well is D & A, then obtain approval of plan when calling district office prior to setting surface pipe.
6. Submit plugging report (CP-4) to K.C.C. after plugging is completed.
7. Obtain an approved injection docket number before disposing of salt water.
8. Notify K.C.C. within 10 days when injection commences or terminates.

A Regular Section of Land
1 Mile = 5,280 Ft.

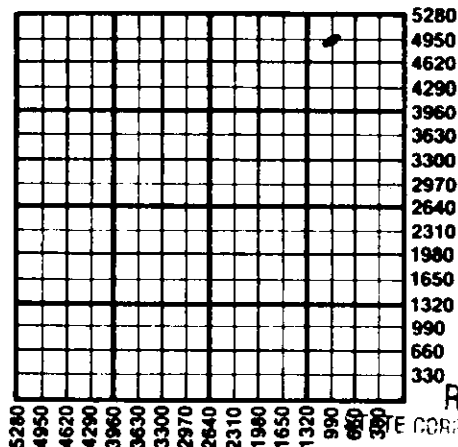

RECEIVED

DEC 1 0 1986

CONSERVATION DIVISION
Wichita, Kansas

on alternate 2 completion, cement in the production pipe from below any usable water to surface within 120 days of spud date.

State Corporation Commission of Kansas
Conservation Division
200 Colorado Derby Building
Wichita, Kansas 67202
(316) 263-3238