CARD MUST BE TYPED

State of Kansas

NOTICE OF INTENTION TO DRILL

(see rules on reverse side)

CARD MUST BE SIGNED

Starting Date: 12/14/84 (month / day / year)

API Number 15- 135-22,747-0000

OPERATOR: License # 5198

Name A. Scott Ritchie

Address 125 N. Market, Suite 950

City/State/Zip Wichita, Kansas 67202

Contact Person Leah Ann Kasten

Phone 316/267-4375

CONTRACTOR: License # 6033

Name Murfin Drilling

City/State Wichita, Kansas

(location) N/2 NW SE Sec 1 Twp 20S Rge 21 [ ] East [X] West

2310 Ft North from Southeast Corner of Section

1980 Ft West from Southeast Corner of Section

(Note: Locate well on Section Plat on reverse side)

Nearest lease or unit boundary line 330 feet.

County Ness

Lease Name Kathryn Young Well# 1

Domestic well within 330 feet: [ ] yes [X] no

Municipal well within one mile: [ ] yes [X] no

Well Drilled For:	Well Class:	Type Equipment:
[X] Oil [ ] Swd	[ ] Infield	[X] Mud Rotary
[ ] Gas [ ] Inj	[ ] Pool Ext.	[ ] Air Rotary
[ ] OWWO [ ] Expl	[X] Wildcat	[ ] Cable

If OWWO: old well info as follows:

Operator

Well Name

Comp Date Old Total Depth

Projected Total Depth 4450 feet

Projected Formation at TD Mississippi

Expected Producing Formations Mississippi

Depth to Bottom of fresh water 100 feet

Lowest usable water formation Dakota

Depth to Bottom of usable water 500 feet

Surface pipe by Alternate: 1 [ ] 2 [X]

Surface pipe to be set 240 feet

Conductor pipe if any required feet

Ground surface elevation est. 2253 feet MSL

This Authorization Expires 6-10-85

Approved By 12-10-84 RC

I certify that we will comply with K.S.A. 55-101, et seq., plus eventually plugging hole to K.C.C. specifications.


Date 12/7/84 Signature of Operator or Agent Leah Ann Kasten Title Geologist

Form C-1 4-84

MHC/KOHE 12/10/84

Must be filed with the K.C.C. five (5) days prior to commencing well
This card void if drilling not started within six (6) months of date received by K.C.C.

A Regular Section of Land
1 Mile = 5,280 Ft.

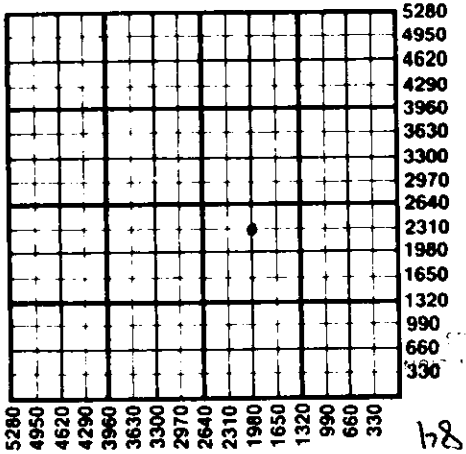

Important procedures to follow:

1. Notify District office before setting surface casing.
2. Set surface casing by circulating cement to the top.
3. File completion forms ACO-1 with K.C.C. within 90 days of well completion, following instructions on ACO-1, side 1, and including copies of wireline logs.
4. Notify District office 48 hours prior to old well workover or re-entry.
5. Prior to plugging, prepare a plugging plan, then obtain agreement from the appropriate district office for an approved plugging plan.
6. Submit plugging report (CP-4) to K.C.C. after plugging is completed.
7. Obtain an approved injection docket number before disposing of salt water.
8. Notify K.C.C. within 10 days when injection commences or terminates.
9. If an alternate 2 completion, cement in the production pipe from below any usable water to surface within 120 days of spud date.

DEC 1 0 84

State Corporation Commission of Kansas
Conservation Division
200 Colorado Derby Building
Wichita, Kansas 67202
(316) 263-3238