

Notice: Fill out COMPLETELY  
and return to Conservation Division at  
the address below within  
60 days from plugging date.

KANSAS CORPORATION COMMISSION  
OIL & GAS CONSERVATION DIVISION  
**WELL PLUGGING RECORD**  
K.A.R. 82-3-117

Form CP-4  
March 2009  
Type or Print on this Form  
Form must be Signed  
All blanks must be Filled

OPERATOR: License #: 32119  
Name: Northern Natural Gas Company  
Address 1: 9480 West Hwy 50  
Address 2: \_\_\_\_\_  
City: Holcomb State: KS Zip: 67851 + \_\_\_\_\_  
Contact Person: Rick Weathered  
Phone: (402) 530-6322  
Type of Well: (Check one) ☐ Oil Well ☐ Gas Well ☐ OG ☐ D&A ☒ Cathodic  
☐ Water Supply Well ☐ Other: \_\_\_\_\_ ☐ SWD Permit #: \_\_\_\_\_  
☐ ENHR Permit #: \_\_\_\_\_ ☐ Gas Storage Permit #: \_\_\_\_\_  
Is ACO-1 filed? ☒ Yes ☐ No If not, is well log attached? ☐ Yes ☐ No  
Producing Formation(s): List All (If needed attach another sheet)  
\_\_\_\_\_  
Depth to Top: \_\_\_\_\_ Bottom: \_\_\_\_\_ T.D. \_\_\_\_\_  
\_\_\_\_\_  
Depth to Top: \_\_\_\_\_ Bottom: \_\_\_\_\_ T.D. \_\_\_\_\_  
\_\_\_\_\_  
Depth to Top: \_\_\_\_\_ Bottom: \_\_\_\_\_ T.D. \_\_\_\_\_

API No. 15 - 055-22153-00-00  
Spot Description: NE Corner of the NNG Holcomb Plant Yard  
NW NE NE NE Sec. 3 Twp. 24 S. R. 34 ☐ East ☒ West  
113 Feet from ☒ North / ☐ South Line of Section  
620 Feet from ☒ East / ☐ West Line of Section  
Footages Calculated from Nearest Outside Section Corner:  
☒ NE ☐ NW ☐ SE ☐ SW  
County: Finney  
Lease Name: 710:1 Holcomb Well #: 710:1 Holc-2  
Date Well Completed: 06-09-12  
The plugging proposal was approved on: \_\_\_\_\_ (Date)  
by: \_\_\_\_\_ (KCC District Agent's Name)  
Plugging Commenced: 06-08-12  
Plugging Completed: 06-09-12

Show depth and thickness of all water, oil and gas formations.

| Oil, Gas or Water Records |         | Casing Record (Surface, Conductor & Production) |      |               |            |
|---------------------------|---------|-------------------------------------------------|------|---------------|------------|
| Formation                 | Content | Casing                                          | Size | Setting Depth | Pulled Out |
| N/A                       |         | 0.511 Wall PVC                                  | 10"  | 40'           | N/A        |
|                           |         |                                                 |      |               |            |
|                           |         |                                                 |      |               |            |
|                           |         |                                                 |      |               |            |

Describe in detail the manner in which the well is plugged, indicating where the mud fluid was placed and the method or methods used in introducing it into the hole. If cement or other plugs were used, state the character of same depth placed from (bottom), to (top) for each plug set.

**\*\*See Attached Drawing\*\***


Plugging Contractor License #: 473 Name: Tyler Water Well, Inc.  
Address 1: 305 Santa Fe Ave. Address 2: \_\_\_\_\_  
City: Holcomb State: KS Zip: 67851 + \_\_\_\_\_  
Phone: (620) 275-5254  
Name of Party Responsible for Plugging Fees: Energy Economics Agent as a consultant for Northern Natural Gas Company  
State of Kansas County, Finney, ss.  
Jim Hulsebus ☐ Employee of Operator or ☒ Operator on above-described well,  
(Print Name)  
being first duly sworn on oath, says: That I have knowledge of the facts statements, and matters herein contained, and the log of the above-described well is as filed, and the same are true and correct, so help me God.  
Signature: Jim Hulsebus

Mail to: KCC - Conservation Division, 130 S. Market - Room 2078, Wichita, Kansas 67202

RECEIVED  
JUL 02 2012  
KCC WICHITA


710:1 Holcomb  
 WO 01058405  
 GBR-Holc Groundbed 710:1 MP 1.07  
 Well # 2 (West Well)  
 13 Anodes #1 thru #13  
 N38.00317  
 W 101.03214  
 API # 15-055-22153-00-00

6-9-12  
 corrected  
 7-9-12

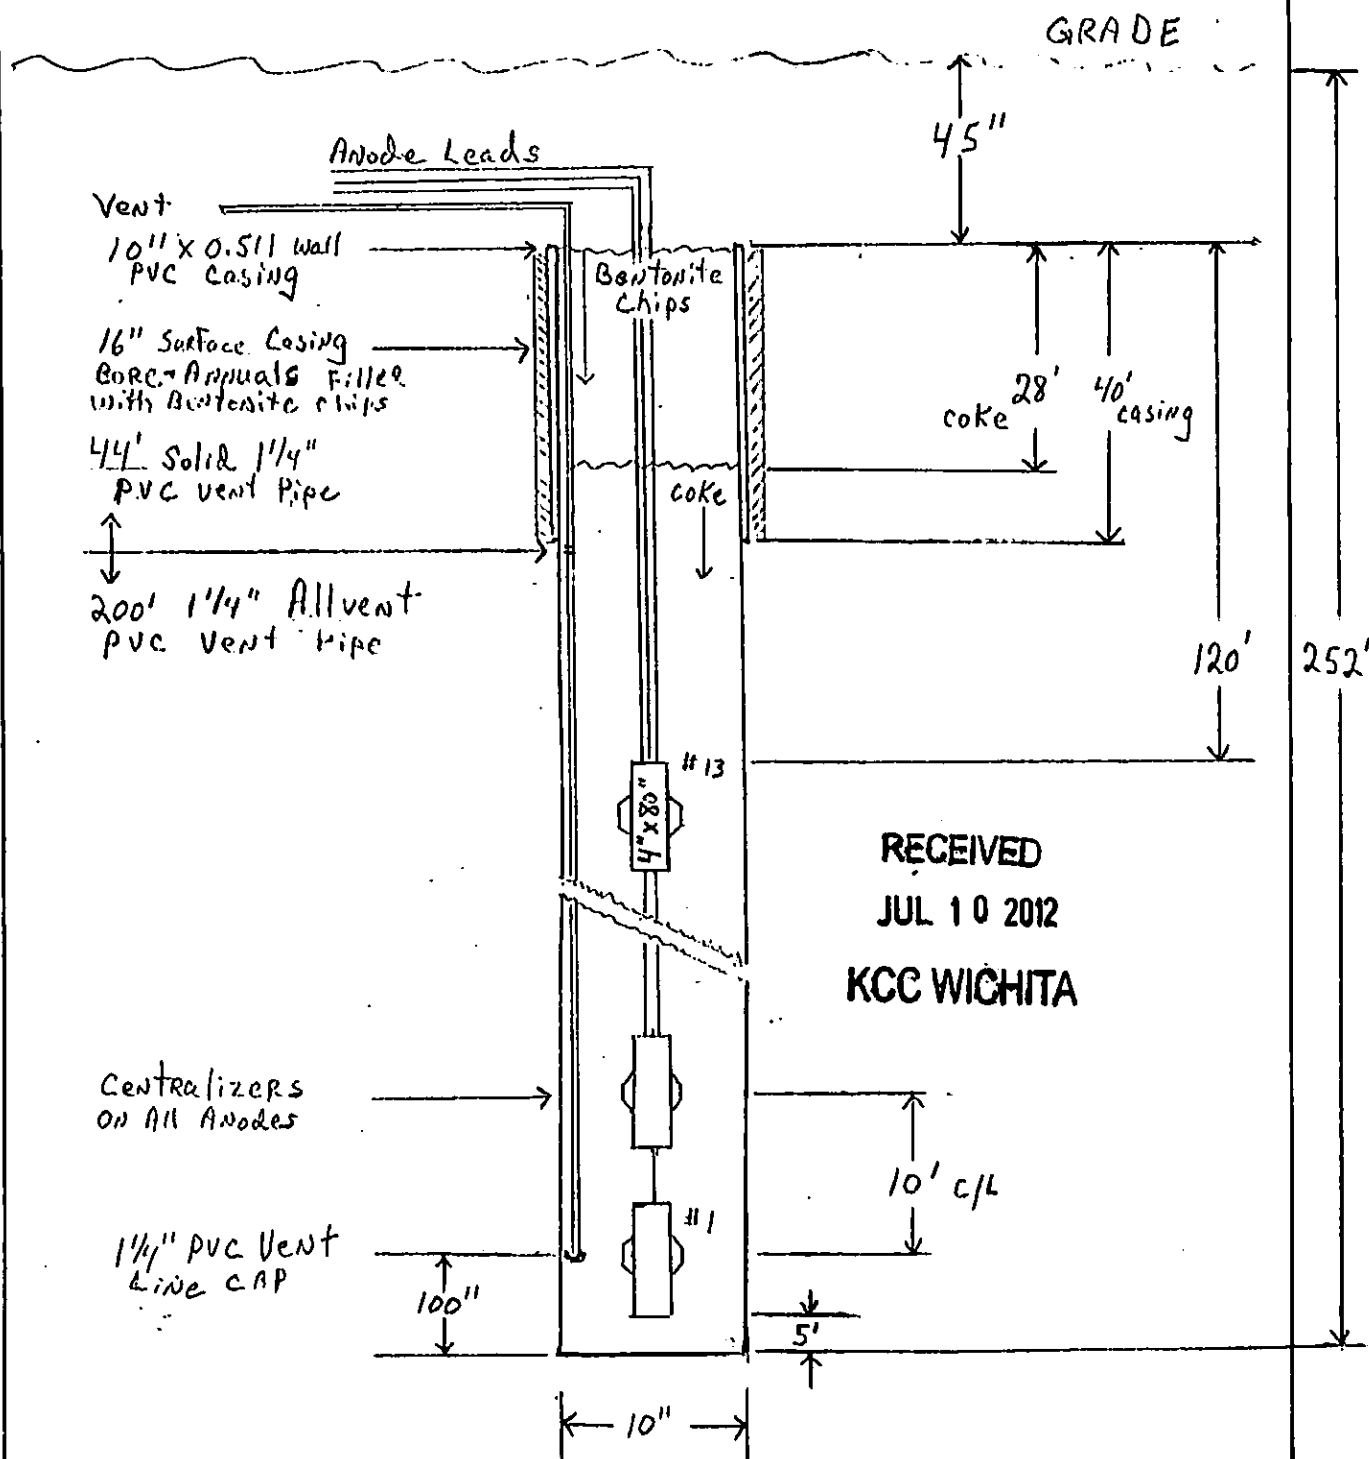



Northern Natural Gas  
Holcomb 710B Deep Well  
Finney County, Kansas

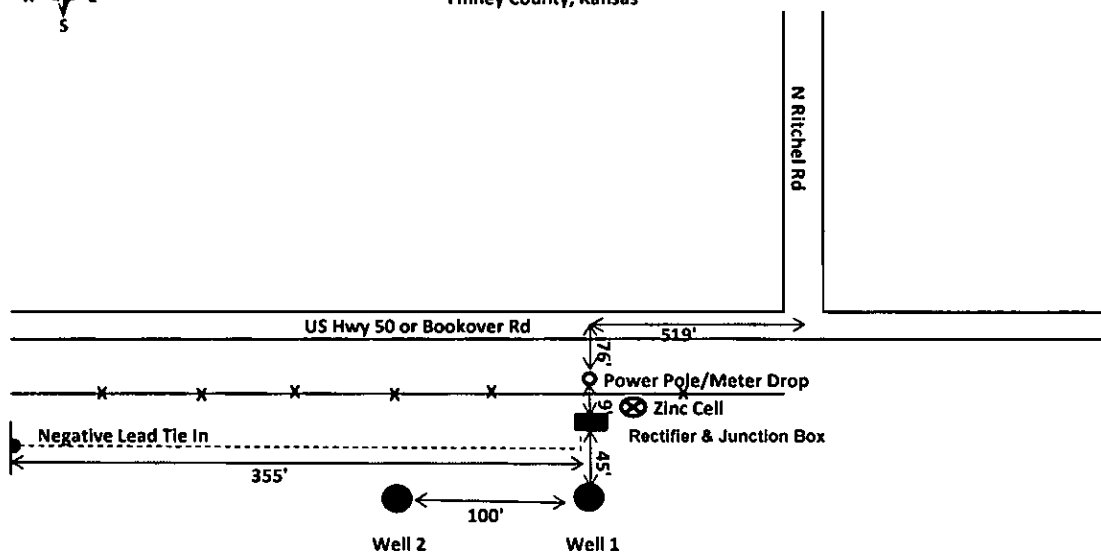

Energy Economics, Inc.  
Installed 25-4x80 Graphite Anodes in 2 Deep Wells  
Date: 06-08-12

RECEIVED  
JUL 02 2012  
KCC WICHITA