

Notice: Fill out COMPLETELY
and return to Conservation Division at
the address below within
60 days from plugging date.

KANSAS CORPORATION COMMISSION
OIL & GAS CONSERVATION DIVISION
WELL PLUGGING RECORD
K.A.R. 82-3-117

Form CP-4
March 2009
Type or Print on this Form
Form must be Signed
All blanks must be Filled

OPERATOR: License #: 32119
Name: Northern Natural Gas Company
Address 1: 9480 West Hwy 50
Address 2: _____
City: Holcomb State: KS Zip: 67851 + _____
Contact Person: Rick Weathered
Phone: (402) 530-6322
Type of Well: (Check one) ☐ Oil Well ☐ Gas Well ☐ OG ☐ D&A ☒ Cathodic
☐ Water Supply Well ☐ Other: _____ ☐ SWD Permit #: _____
☐ ENHR Permit #: _____ ☐ Gas Storage Permit #: _____
Is ACO-1 filed? ☒ Yes ☐ No If not, is well log attached? ☐ Yes ☐ No
Producing Formation(s): List All (If needed attach another sheet)

Depth to Top: _____ Bottom: _____ T.D. _____

Depth to Top: _____ Bottom: _____ T.D. _____

Depth to Top: _____ Bottom: _____ T.D. _____

API No. 15 - 055-22152-00-00
Spot Description: NE Corner of the NNG Holcomb Plant Yard
NW NE NE NE Sec. 3 Twp. 24 S. R. 34 ☐ East ☒ West
113 Feet from ☒ North / ☐ South Line of Section
520 Feet from ☒ East / ☐ West Line of Section
Footages Calculated from Nearest Outside Section Corner:
☒ NE ☐ NW ☐ SE ☐ SW
County: Finney
Lease Name: 710:1 Holcomb Well #: 710:1 Holc-1
Date Well Completed: 06-09-12
The plugging proposal was approved on: _____ (Date)
by: _____ (KCC District Agent's Name)
Plugging Commenced: 06-08-12
Plugging Completed: 06-09-12

Show depth and thickness of all water, oil and gas formations.

Oil, Gas or Water Records		Casing Record (Surface, Conductor & Production)			
Formation	Content	Casing	Size	Setting Depth	Pulled Out
N/A		0.511 Wall PVC	10"	40'	N/A

Describe in detail the manner in which the well is plugged, indicating where the mud fluid was placed and the method or methods used in introducing it into the hole. If cement or other plugs were used, state the character of same depth placed from (bottom), to (top) for each plug set.

****See Attached Drawing****

Plugging Contractor License #: 473 Name: Tyler Water Well, Inc.
Address 1: 305 Santa Fe Ave. Address 2: _____
City: Holcomb State: KS Zip: 67851 + _____
Phone: (620) 275-5254
Name of Party Responsible for Plugging Fees: Energy Economics Agent as a consultant for Northern Natural Gas Company
State of Kansas County, Finney, ss.
Jim Hulsebus ☐ Employee of Operator or ☒ Operator on above-described well,
(Print Name)

being first duly sworn on oath, says: That I have knowledge of the facts statements, and matters herein contained, and the log of the above-described well is as filed, and the same are true and correct, so help me God.

Signature: Jim Hulsebus

Mail to: KCC - Conservation Division, 130 S. Market - Room 2078, Wichita, Kansas 67202

RECEIVED
JUL 02 2012
KCC WICHITA

710:1 Holcomb

WO 01058405

GBR-Holc Groundbed. 710:1 MP 1.07

Well #1 (East Well)

12 Anodes #1 than #12

N38.00317


W 101.03181

API #15-055-22152-00-00

6-9-12

corrected

7-9-12

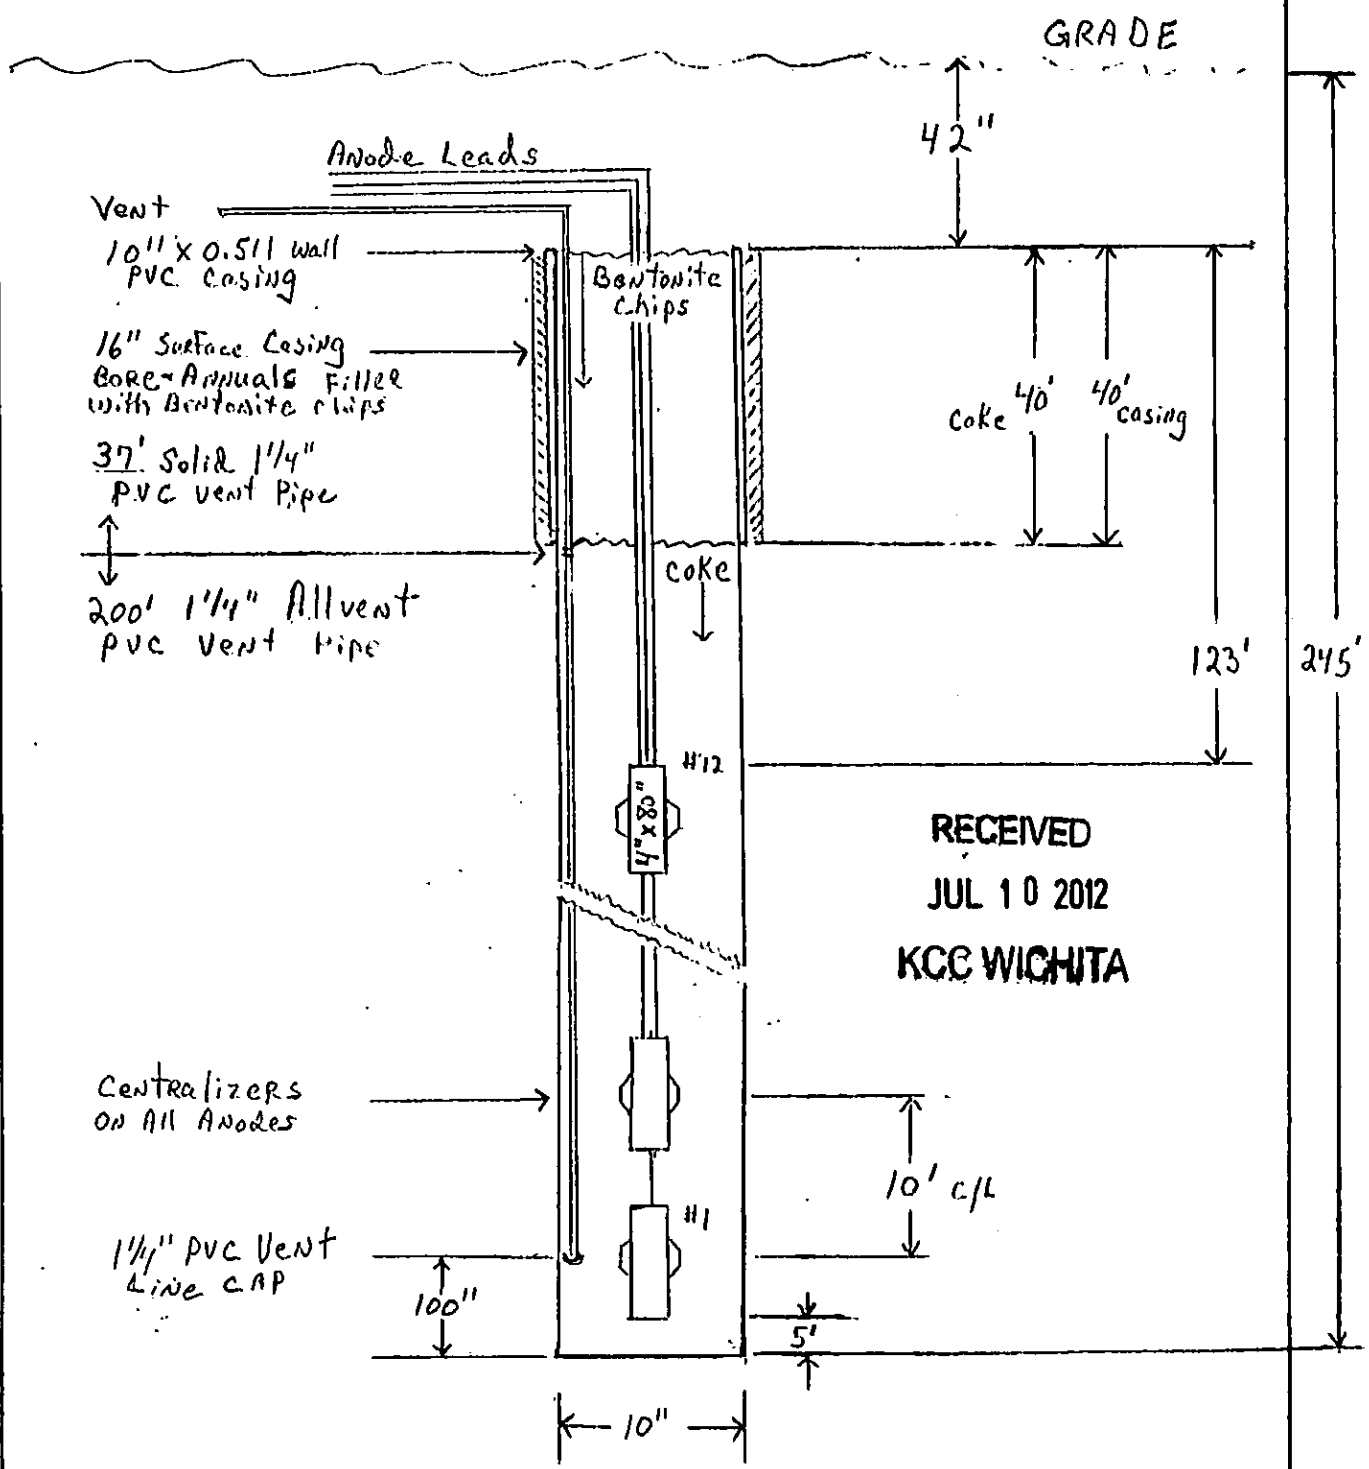

RECEIVED
JUL 10 2012
KCC WICHITA