

STATE OF KANSAS
STATE CORPORATION COMMISSION


WELL PLUGGING RECORD

Give All Information Completely
Make Required Affidavit
Mail or Deliver Report to:
Conservation Division
State Corporation Commission
211 No. Broadway
Wichita, Kansas

STAFFORD County. Sec. 9 Twp. 21s Rge. 13w (R) (W)

Location as "NE/CNW&SW" or footage from lines SW NW SW
Lease Owner PETROLEUM, INC.
Lease Name HARTER "B" Well No. 1
Office Address ROUTE 2, GREAT BEND, KANSAS
Character of Well (completed as Oil, Gas or Dry Hole) DRY HOLE
Date well completed JUNE 30, 19 63
Application for plugging filed JUNE 30, 19 63
Application for plugging approved JUNE 30, 19 63
Plugging commenced JUNE 30, 19 63
Plugging completed JUNE 30, 19 63
Reason for abandonment of well or producing formation NO PRODUCIBLE FORMATIONS

NORTH

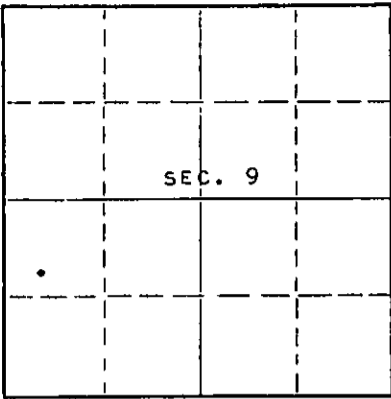

Locate well correctly on above Section Plat

If a producing well is abandoned, date of last production NONE 19
Was permission obtained from the Conservation Division or its agents before plugging was commenced? YES

Name of Conservation Agent who supervised plugging of this well ARCHIE ELVING
Producing formation - - Depth to top - - Bottom - - Total Depth of Well 3687 Feet
Show depth and thickness of all water, oil and gas formations.

OIL, GAS OR WATER RECORDS

CASING RECORD

FORMATION	CONTENT	FROM	TO	SIZE	PUT IN	PULLED OUT
				8-5/8	200	NONE

Describe in detail the manner in which the well was plugged, indicating where the mud fluid was placed and the method or methods used in introducing it into the hole. If cement or other plugs were used, state the character of same and depth placed, from feet to feet for each plug set.

THIS IS A WASHDOWN HOLE

MUDDERED UP WITH HEAVY MUD TO 220', FOLLOWED BY WOODEN PLUG AND 1/4 SACK HULLS. PLACED 20 SACKS CEMENT THROUGH DRILL PIPE ONTO HULLS. MUDDERED UP WITH HEAVY MUD TO 40', FOLLOWED BY WOODEN PLUG, 1/4 SACK HULLS AND 10 SACKS CEMENT TO BASE OF WELL CELLAR. PLACED 2 SACKS CEMENT IN RAT HOLE.

RECEIVED
STATE CORPORATION COMMISSION
JUL 15 1963
7-15-63
CONSERVATION DIVISION
Wichita, Kansas

(If additional description is necessary, use BACK of this sheet)
Name of Plugging Contractor GARVEY DRILLING COMPANY
Address ROUTE 2, GREAT BEND, KANSAS

STATE OF KANSAS, COUNTY OF BARTON, ss.
DON SEARLE (employee of owner) or (owner/contractor) of the above-described

well, being first duly sworn on oath, says: That I have knowledge of the facts, statements and matters herein contained and the log of the above-described well as filed and that the same are true and correct. So help me God.

(Signature) DON SEARLE, DIST. PROD. SUPT.
ROUTE 2, GREAT BEND, KANSAS
(Address)

SUBSCRIBED AND SWORN TO before me this 11TH day of JULY, 19 63

My commission expires APRIL 14, 1967
Notary Public.

WELL LOG

15-185-00718-00-01

COMPANY Petroleum Inc

SEC. 9 T. 21S. R. 13W

FARM Harter

NO. B-1 (Washdown)

LOC. SW NW SW


TOTAL DEPTH 3687'

COUNTY Stafford

COMM. 6-29-63

COMP. 6-30-63

CONTRACTOR Garvey Drilling Company

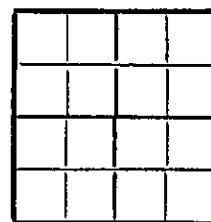

CASING 8 5/8" @ 200' w/175 sx

ELEVATION 1896' D.F.

PRODUCTION D & A

FIGURES INDICATE BOTTOM OF FORMATIONS

This is an old well workover of a well drilled by Garvey Drilling Company on November 12, 1951.

Garvey Drilling Company washed this hole down 6-30-63, Log TD 3687'.

RECEIVED
STATE CORPORATION COMMISSION

JUL 15 1963

CONSERVATION DIVISION
Wichita, Kansas

State of Kansas }
County of Barton } ss

I, Sam N. Stephens of Garvey Drilling Company

upon oath state the above and foregoing is a true and correct copy of the log of the Harter B-1 (Washdown) well.

Sam N. Stephens

Subscribed and sworn to before me this 11th day of July 19 63

My Commission Expires: April 14th, 1967

Arthur J. Wiles
NOTARY PUBLIC