


STATE OF KANSAS
STATE CORPORATION COMMISSION

WELL PLUGGING RECORD

Give All Information Completely
Make Required Affidavit
Mail or Deliver Report to
Conservation Division
State Corporation Comm.
245 North Water
Wichita, KS 67202

COWLEY County. Sec. 33 Twp. 34s Rge. 3E E/W
Location as "NE/CNW/SW" or footage from lines _____

C W/2 SW/4 NW/4
Lease Owner GEOSON OIL CO INC
Lease Name PLECKER Well No. #1
Office Address 212 N. MARKET WICHITA, KS
Character of Well (Completed as Oil, Gas or Dry Hole) _____

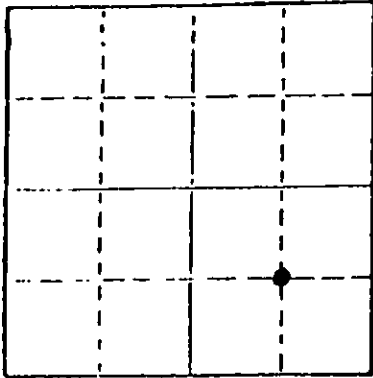

Locate well correctly on above Section Plat

DRY HOLE
Date Well completed 11-6 1980
Application for plugging filed 11-6 1980
Application for plugging approved 11-6 1980
Plugging commenced 11-6 1980
Plugging completed 11-6 1980
Reason for abandonment of well or producing formation _____

DRY HOLE
If a producing well is abandoned, date of last production _____ 19____

Was permission obtained from the Conservation Division or its agents before plugging was commenced? YES

Name of Conservation Agent who supervised plugging of this well CARL BARNETT
Producing formation _____ Depth to top _____ Bottom _____ Total Depth of Well 3296
Show depth and thickness of all water, oil and gas formations.

OIL, GAS OR WATER RECORDS

CASING RECORD

FORMATION	CONTENT	FROM	TO	SIZE	PUT IN	PULLED OUT
		0	264	8 3/8	264	NONE

Describe in detail the manner in which the well was plugged, indicating where the mud fluid was placed and the method or methods used in introducing it into the hold. If cement or other plugs were used, state the character of same and depth placed, from _____ feet to _____ feet for each plug set.

MUD TO 263' PLUG 30 SACKS CEMENT

MUD TO 40' PLUG 10 SACKS CEMENT

3 SACKS CEMENT IN RAT HOLE

Red 12-9-80

(If additional description is necessary, use BACK of this sheet)

Name of Plugging Contractor BLUE STREAK DRILLING INC.

STATE OF KANSAS COUNTY OF COWLEY, ss.
Lars Larson (employee of owner) or (owner or operator)
of the above-described well, being first duly sworn on oath, says: That I have knowledge of the facts, statements, and matters herein contained and the log of the above-described well as filed and that the same are true and correct. So help me God.

(Signature) Lars Larson
1037 Highland Drive Oak City, KS
(Address)

SUBSCRIBED AND SWORN TO before me this 1st day of December, 1980

Walter W. Bishop
Notary Public.

My commission expires 12-18-81

15-035-22698-0000

DRILLERS LOG

CASING RECORD:
264' 8 ⁵/₈

COMPANY: GEOSON OIL CO. INC.
CONTRACTOR: BLUESTREAK DRILLING
COMMENCED: 10-20-80
COMPLETED: 11-6-80

DESCRIPTION:
C W/2 S W/4 NW/4
SEC 33-34S-3E

TOTAL DEPTH:
3796 FT.

ELEVATION:
KB 1158
GL 1153

<u>FORMATION</u>	<u>FROM</u>	<u>TO</u>	<u>REMARKS</u>
SEV'RY	1422	-264	SAND
LAYTON	2658	-1500	SAND
LANSING	2868	-1710	LIME
CLEVELAND	2988	-1836	SAND
MISS.	3374	-	LIME
SIMPSON	3693	-	SAND

I certify that this is a true and correct copy of the above log to the best of my knowledge.

BLUE STREAK DRILLING INC.

Lars Larson

DEC - 3 1980


Subscribed and sworn to before me this 1st day of December, 1980

Walter W. Bishop
Notary Public

My Commission Expires: 12-18-81