

15-135-30065-00-00

STATE OF KANSAS
STATE CORPORATION COMMISSION


Form CP-4

Give All Information Completely
Make Required Affidavit
Mail or Deliver Report to:
Conservation Division
State Corporation Commission
P. O. Box 17027
Wichita, Kansas 67217

WELL PLUGGING RECORD

*Note: This was
Donald C. Slawson #1 DeWald "A"

Ness County, Sec. 7, Twp. 19 Rge. (E) 21 (W)
Location as "NE/CNWESW" or footage from lines. C NE SW
Lease Owner Palomino Petroleum
Lease Name DeWald "C" Well No. 13
Office Address 304 Insurance Bldg., Wichita, Kansas 67202
Character of Well (completed as Oil, Gas or Dry Hole) oil
Date well completed August 5 19 65
Application for plugging filed June 10 19 74
Application for plugging approved June 11 19 74
Plugging commenced June 19 19 74
Plugging completed July 12 19 74
Reason for abandonment of well or producing formation
Non-Commercial

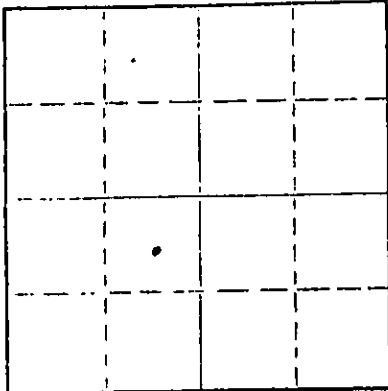

Locate well correctly on above
Section Plat

If a producing well is abandoned, date of last production app. February 19 74
Was permission obtained from the Conservation Division or its agents before plugging was commenced? YES

Name of Conservation Agent who supervised plugging of this well Leo Massey
Producing formation Mississippian Depth to top 4291 Bottom Total Depth of Well 4404 Feet
Show depth and thickness of all water, oil and gas formations.

OIL, GAS OR WATER RECORDS

CASING RECORD

FORMATION	CONTENT	FROM	TO	SIZE	PUT IN	PULLED OUT
				8 5/8"	312'	none
				4 1/2"	4403'	none

Describe in detail the manner in which the well was plugged, indicating where the mud fluid was placed and the method or methods used in introducing it into the hole. If cement or other plugs were used, state the character of same and depth placed, from _____ feet to _____ feet for each plug set.

Sanded back to 4200' and dumped 3 sacks of cement.

Set rock bridge at 500' and plugged well with 2 yards of ready mix cement.

RECEIVED
STATE CORPORATION COMMISSION
JUL 18 1974
CONSERVATION DIVISION
Wichita, Kansas
07-18-1974

Name of Plugging Contractor PIPE PULLERS, INC.
Address Box 486, Ellinwood, Kansas 67526

STATE OF KANSAS COUNTY OF BARTON, ss.
Evelyn Roth

(employee of owner) or (owner or operator) of the above-described well, being first duly sworn on oath, says: That I have knowledge of the facts, statements, and matters herein contained and the log of the above-described well as filed and that the same are true and correct. So help me God.

(Signature) Evelyn Roth
Ellinwood, Kansas

SUBSCRIBED AND SWORN TO before me this 17th day of July, 19 74

My commission expires Feb. 10, 1974

Serge A. Meyer
Notary Public.

WELL LOG BUREAU—KANSAS GEOLOGICAL SOCIETY
 508 East Murdock, Wichita, Kansas


15-135-30005-00-00

Company- DONALD C. SLAWSON
 Farm- DE Wald "A" No. 1

SEC. 7 T. 19 R. 21W
 C NE SW

Total Depth. 4404'
 Comm. 5-27-65 Comp. 6-7-65
 Shot or Treated.
 Contractor. Leban Drig. Co., Inc.
 Issued. 10-9-65

County Ness
 KANSAS

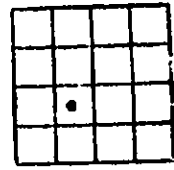

CASING:

8 5/8" 312' w/200 sx cem.
 4 1/2" 4403' w/125 xx cem.

Elevation. 2185' KB
 Production. Pmp. 47 BOPD-NW

Figures Indicate Bottom of Formations.

shale, hrd.	215
shale	312
shale, sand	1300
shale	1415
Anhydrite	1452
shale	2140
shale, lime	2885
shale	3225
shale, lime	3817
lime	4276
lime, Conglomerate	4295
lime	4400 RTD
No Record	4404
Total Depth	

TOPS: SCOUT

Anhydrite	1418
Heebner	3650
Lansing	3696
B/Kansas City	3994
Cherokee shale	4172
Mississippi	4274
Mississippi Oasge	4290
Gil City	4382

RECEIVED
 06-11-1974